


NARRATIVE

THIS SURVEY WAS PERFORMED AT THE REQUEST OF LEA GREENWOOD, ACTING IN BEHALF OF THE UNITY COMMUNITY RECREATION DISTRICT.


THE PURPOSE OF THIS SURVEY WAS TO LOCATE THE CORNERS OF THE COM-MUNITY HALL TRACT AS SHOWN HEREON.

A SEARCH WAS MADE OF THE AVAILABLE RECORDS PERTAINING TO THIS SURVEY. FIELD MEASUREMENTS WERE MADE TO LOCATE THE APPURTENANT MONUMENTS OF RECORD SURVEY NO. 13—37—18, SET IN NOV. 1994 BY JAMES HANLEY, PLS 1206. WE FOUND FOUR OF THE CONTROLLING MONUMENTS AS SHOWN HEREON. THE SW MONUMENT OF THIS TRACT WAS MISSING.

I HELD THE RECORD BEARING AND DISTANCE FROM THE FOUND MONUMENTS AT THE SE AND NW CORNERS OF THIS TRACT AND RESET THE SW CORNER AT ITS

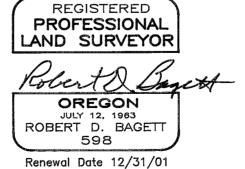

PAKER COUNTY SUNTETON SURVEY IND. 13-3,7-21

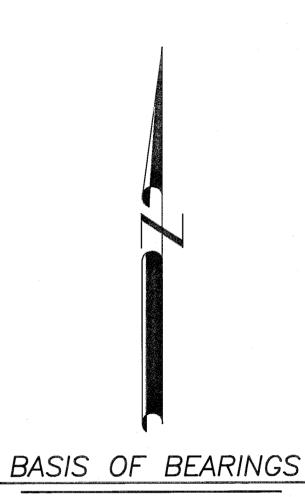

RECORD MAP OF SURVEY NO. 13-37-18
AS SHOWN

REFERENCES

RECORD MAP OF SURVEY NO. 13-37-18
DEED RECORD INSTRUMENT NO. 82-33-061

LEGEND

- FOUND 5/8" IRON PIN WITH ATTACHED YELLOW PLASTIC CAP MARKED HANLEY ENGR. PLS 1206 FROM RECORD MAP OF SURVEY NO. 13-37-18
- FOUND 5/8" IRON PIN NO CAP
- O SET 5/8"X30" IRON PIN WITH ATTACHED YELLOW PLASTIC CAP MARKED BGB SURVEY MARKER
- () RECORD BEARING AND DISTANCE
- X-X FENCE LINE

