


RECORD OF LAND CORNER MONUMENTATION

CORNER: N1/4 Cor. Sec. 30, Twp. 13 S., R. 37 E., W.M.
ORIGINAL SURVEY BY: George Henderson, U.S. Deputy Surveyor
CONTRACT NUMBER: 409
CONTRACT DATE: August 22, 1881

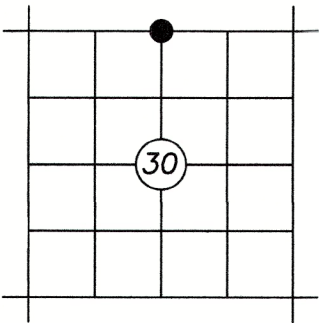

ORIGINAL G.L.O. DESCRIPTION: Drove cottonwood post 3 ft long and 2 ins Square for 1/4 Sec cor. Marked 1/4S on W. side. dug pits 20x12x10 ins. E and W of post 5 ft. dist and raised a mound of earth 2 ft. high 2½ ft diam. at base around post.


EVIDENCE FOUND: None. after a diligent search, I determine this corner lost and placed a monument by single proportionate measure between the Section Corners to the East and West.

DESCRIPTION OF MONUMENT AND ACCESSORIES SET:
At the corner point I set a 5/8"X30" iron pin with attached 2½" aluminum cap, 27 inches the ground. Built a 1 ft. mound of stone around iron pin.

FROM WHICH, I SET THE FOLLOWING REFERENCE POINTS:
A 5/8"X30" iron pin bears S.46°46'E., 23.31 ft., with attached yellow plastic cap marked BENCHMARK SURVEYING

A 5/8"X30" iron pin bears N.48°18'W., 23.75 ft., with attached yellow plastic cap marked BENCHMARK SURVEYING

ALSO FROM WHICH, I SCRIBE THE FOLLOWING BEARING TREES:
A Juniper, 4½" DBH, bears N.65°E., 48.0 ft., marked S1/4 S19 BT
A Juniper, 5" DBH, bears S.58°W., 60.6 ft., marked N1/4 S30 BT

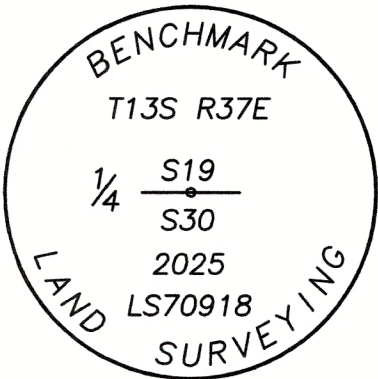

Used RTK GPS to measure Reference Points and bearings to trees. Bearings to RP's and BT's are based on Baker County Survey 13-36-94. Used a steel tape to measure to a 40d nail driven into the side-center of the root crown of BT's. Placed BT tag on Bearing Trees.

Work Performed BY:
Michael C. Springer, PLS
Thea Ensign, Technician

Benchmark Land Surveying, Inc.
217 N. Canyon Blvd.
John Day, OR, 97845
(541) 620-0676
mike@benchmarkls.com

Surveyed: June 12, 2025



EXPIRES: 6/30/2026

FILED July 8, 2025
BAKER COUNTY SURVEYOR
SURVEY NO. 13-37-40