


RECORD OF LAND CORNER MONUMENTATION

CORNER: C-W1/16 Cor. Sec. 30, Twp. 13 S., R. 37 E., W.M.

ORIGINAL SURVEY BY: CORNER

CONTRACT NUMBER: NOT PREVIOUSLY

CONTRACT DATE: ESTABLISHED

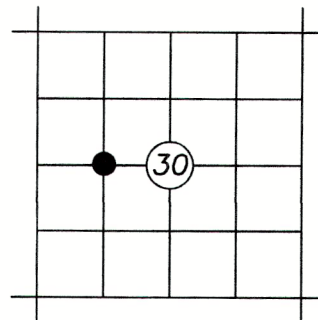

ORIGINAL G.L.O. DESCRIPTION: None, Corner not previously established.

EVIDENCE FOUND: None, Corner not previously established.


DESCRIPTION OF MONUMENT AND ACCESSORIES SET:

At the corner point I set a 5/8"X30" iron pin with attached 2" aluminum cap, 27" in the ground. Cap is marked as shown below.

FROM WHICH, I SET THE FOLLOWING REFERENCE POINTS:

A 5/8"X30" iron pin bears N.39°57'E., 20.70 ft., with attached yellow plastic cap marked BENCHMARK SURVEYING

A 5/8"X30" iron pin bears S.40°50'W., 21.90 ft., with attached yellow plastic cap marked BENCHMARK SURVEYING

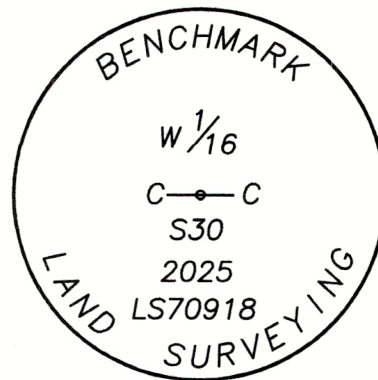


Used RTK GPS to measure Reference Points. Bearings are based on Baker County Survey No. 13-36-94.

Work Performed BY:

Michael C. Springer, PLS
Thea Ensign, Technician

Benchmark Land Surveying, Inc.
217 N. Canyon Blvd.
John Day, OR, 97845
(541) 620-0676
mike@benchmarkls.com

Surveyed: June 12, 2025

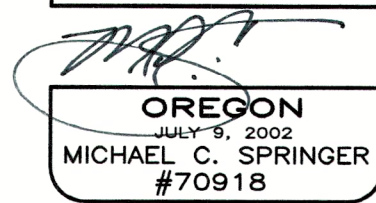

EXPIRES: 6/30/2026

FILED July 8, 2025
BAKER COUNTY SURVEYOR
SURVEY NO. 13-37-42

T-02