


RECORD OF LAND CORNER MONUMENTATION

CORNER: N1/4 Cor. Sec. 31, Twp. 13 S., R. 37 E., W.M.
ORIGINAL SURVEY BY: George Henderson, U.S. Deputy Surveyor
CONTRACT NUMBER: 409
CONTRACT DATE: August 22, 1881

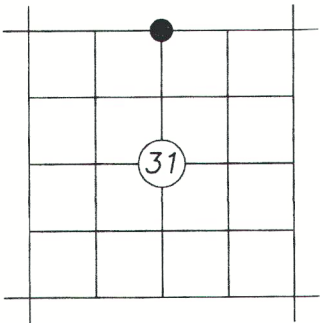

ORIGINAL G.L.O. DESCRIPTION: Drove cottonwood post 3 feet long and 2½ inches square for 1/4 Sec cor, marked 1/4 S on west side. dug pits 20x12x10 ins. E and W of post, 5 ft dist. and raised a mound of earth 2 feet high and 2½ feet diam. at base of post.

EVIDENCE FOUND: None. after a diligent search, I determine this corner lost and placed a monument by single proportionate measure between the Section Corners to the East and West.

It is worth noting that even though no conclusive evidence was found of the original corner, the convergence of East, West and South scattered deteriorated fencing remains were found in the vicinity.


DESCRIPTION OF MONUMENT AND ACCESSORIES SET:
At the corner point I set a 5/8"X30" iron pin with attached 2½" aluminum cap, 27" in the ground. Built a 2 ft. mound of stone around iron pin. The Cap is marked as shown below.

- FROM WHICH, I SET THE FOLLOWING REFERENCE POINTS:**
A 5/8"X30" iron pin bears N.36°16'E., 18.28 ft., with attached yellow plastic cap marked BENCHMARK SURVEYING

A 5/8"X30" iron pin bears S.46°09'E., 18.89 ft., with attached yellow plastic cap marked BENCHMARK SURVEYING

A 5/8"X30" iron pin bears S.40°41'W., 18.33 ft., with attached yellow plastic cap marked BENCHMARK SURVEYING

A 5/8"X30" iron pin bears N.50°58'W., 14.30 Ft., with attached yellow plastic cap marked BENCHMARK SURVEYING

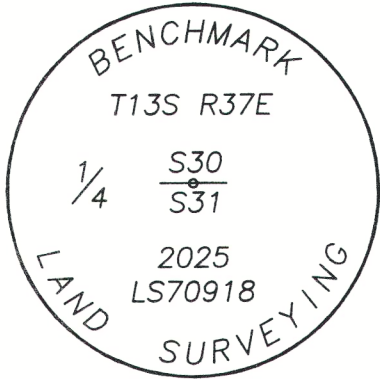

Used RTK GPS to measure Reference Points. Bearings are based on Baker County Survey 13-36-94.

Work Performed BY:
Michael C. Springer, PLS
Thea Ensign, Technician

Benchmark Land Surveying, Inc.
217 N. Canyon Blvd.
John Day, OR, 97845
(541) 620-0676
mike@benchmarkls.com

Surveyed: June 12, 2025



FILED July 8, 2025
BAKER COUNTY SURVEYOR
SURVEY NO. 13-37-43