


CERTIFIED RECORD OF LAND CORNER MONUMENTATION

HISTORY OF ORIGINAL CORNER ESTABLISHED:

Corner was originally established under GLO contract number 148, dated May 17th, 1871, executed by John S. Kincaid. Surveyor General field notes state:

Set stone 10x10x7 for 1/4 S. Cor.

T 13 S R 40 E A-07

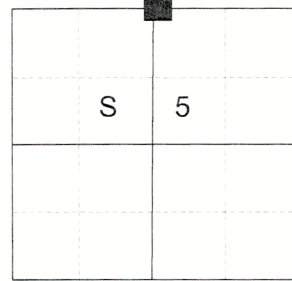

DESCRIPTION OF CORNER EVIDENCE FOUND:

Found 4' mound of stone from which:
An 11" diam. Ponderosa Pine bears Southwesterly, 10 feet, standing dead with BLM location tag stating corner is 10 ft. NE.
An 11" diam. Ponderosa Pine bears Westerly, 40 feet, with BLM location tag stating corner is 40.00 ft. East. Tags bear dates of 1956.

DESCRIPTION OF MONUMENT AND ACCESSORIES I ESTABLISHED TO MONUMENT THE ORIGINAL LOCATION OF THIS CORNER:

At the center of the stone mound, I set a 2 1/2" aluminum pipe, 25" in the ground and in a 4 ft. diam. mound of stone, with 3" aluminum cap marked as shown below, from which:


NEW BEARING OBJECTS:

A 7" Ponderosa Pine bears North 17° East, a distance of 17.95 feet, marked 1/4 S32 BT.
A 7" Ponderosa Pine bears South 52° East, a distance of 10.90 feet, marked 1/4 S5 BT.
A 6" Ponderosa Pine bears South 72° West, a distance of 15.05 feet, marked 1/4 S5 BT
A 14" Ponderosa Pine bears North 56° West, a distance of 12.15 feet, marked 1/4 S32 BT

Set steel fence post approx. 1 ft. West

I hereby certify that the corner was monumented on May 1, 2025

Witness: Kyle Tucker

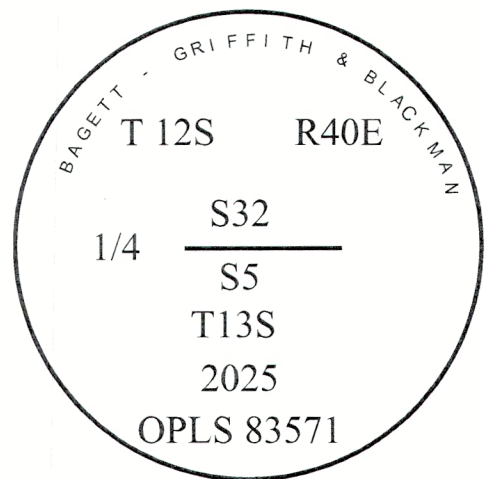

Renewal Date: June 30, 2027

I use a tape and compass in the establishment of the new bearing objects. 14° East was used for declination and measured to a brass washer labeled "OPLS 83571" in the BT blaze at the base of the tree. Distances are to a 60D nail in the right side of the base of the center of the tree.

A-07

FILED June 25, 2025
BAKER COUNTY SURVEYOR
SURVEY NO. 12-40-38
13-40-2