

CERTIFIED RECORD OF LAND CORNER MONUMENTATION

HISTORY OF ORIGINAL CORNER ESTABLISHED:

Corner was originally established under GLO contract number 148, dated May 17th, 1871, executed by John S. Kincaid. Surveyor General field notes state:

Set stone 12x9x7 for 1/4 S. Cor.

T 13 S R 40 E A-11

	S	4	

DESCRIPTION OF CORNER EVIDENCE FOUND:

None. Multiple stones fall in fence rock jacks Southwest of computed position but none with discernible marks. The fence appears to be constructed without regards to property lines.

DESCRIPTION OF MONUMENT AND ACCESSORIES I ESTABLISHED TO MONUMENT THE

ORIGINAL LOCATION OF THIS CORNER: At proportionate position by Survey I set a 2 1/2" aluminum pipe, 27" in the ground, with 3" aluminum cap marked as shown below, from which:


NEW BEARING OBJECTS:

A 5/8" x 30" iron pin bears North 44°14' East, a distance of 15.40 feet, marked BGB SURVEY MARKER NE RP
A 5/8" x 30" iron pin bears South 51°11' East, a distance of 20.46 feet, marked BGB SURVEY MARKER SE RP
A 5/8" x 30" iron pin bears South 34°01' West, a distance of 17.81 feet, marked BGB SURVEY MARKER SE RP
A 6 in. Ponderosa Pine bears North 14° West, a distance of 41.20 feet, marked 1/4 S33 BT.

Set steel fence post approx. 1 ft. East
Northwest/Southeast bearing fence line falls approx. 50 ft. Southwest.

I hereby certify that the corner was monumented on May 1, 2025

Witness: Kyle Tucker

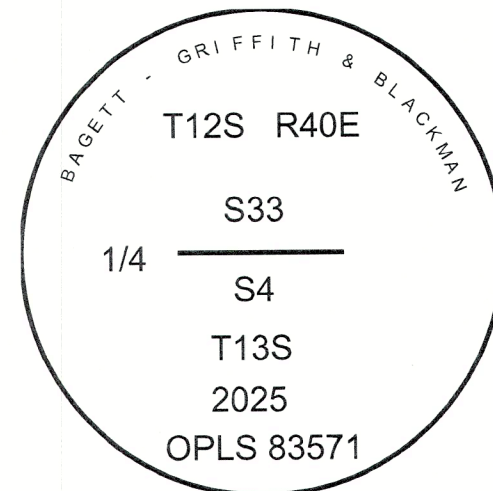

I use a Leica GS18 with RTK in the establishment of the new bearing objects. Basis of Bearing is as per the "Oregon Coordinate Reference System Baker Zone". Bearings and distances are measured to the center of the aluminum caps. I use a steel tape and compass in the establishment of the bearing tree. Magnetic Declination used was 14° East. Bearings are to a brass washer in the BT blaze marked OPLS 83571. Distances are to a 60d spike in the side of the root crown of the tree.

A-11

FILED June 25, 2025
BAKER COUNTY SURVEYOR
SURVEY NO. 12-40-41
13-40-5