

CERTIFIED RECORD OF LAND CORNER MONUMENTATION

HISTORY OF ORIGINAL CORNER ESTABLISHED:

Corner was originally established under GLO contract number 148, dated May 17th, 1871, executed by John S. Kincaid. Surveyor General field notes state:

Set stone 20x14x9 for cor. to secs. 2, 3, 34, + 24

Corner recovered by George Henderson under GLO contract Number 409. Surveyor General field notes state:

From the cor. of sec 2, 3, 34, and 35 on the South boundary of the townships which is a stone 12x8x6 marked with 2 notches on East side in mound of stones"

T 13 S R 40 E A-17

	S	3	

DESCRIPTION OF CORNER EVIDENCE FOUND:

None.

DESCRIPTION OF MONUMENT AND ACCESSORIES I ESTABLISHED TO MONUMENT THE ORIGINAL LOCATION OF THIS CORNER:

At proportionate position, I set a 2 1/2" x 30" aluminum pipe, set 28" in the ground and in a 2 ft. diam. mound of stone, with 3" aluminum cap marked as shown below, from which:


NEW BEARING OBJECTS:

- A 5/8" x 15" iron pin bears North 54°46 East, a distance of 9.94, with 1 1/2" aluminum cap marked NE RP
- A 5/8" x 15" iron pin bears South 37°37 East, a distance of 14.05, with 1 1/2" aluminum cap marked SE RP
- A 5/8" x 15" iron pin bears South 36°36 West, a distance of 12.55, with 1 1/2" aluminum cap marked SW RP
- A 5/8" x 15" iron pin bears North 27°47 West, a distance of 11.19, with 1 1/2" aluminum cap marked NW RP

Set steel fence post approx. 2 ft. West

I hereby certify that the corner was monumented on June 4, 2025

Witness: Kyle Tucker

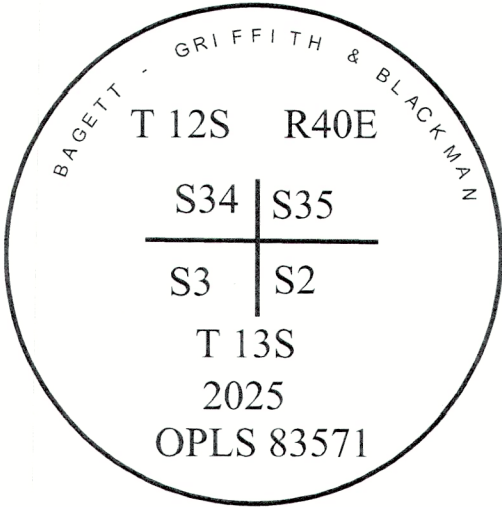

I use a Leica GS18 with RTK in the establishment of the new bearing objects. Basis of Bearing is as per the "Oregon Coordinate Reference System Baker Zone". Bearings and distances are measured to the center of the aluminum caps.

A-17

FILED June 25, 2025
BAKER COUNTY SURVEYOR
SURVEY NO. 12-40-45
13-4-9