


CERTIFIED RECORD OF LAND CORNER MONUMENTATION

HISTORY OF ORIGINAL CORNER ESTABLISHED:

Corner was originally established under GLO contract number 148, dated May 17th, 1871, executed by John S. Kincaid. Surveyor General field notes state:

Set stone 14x10x10 for 1/4 sec. cor.

T 13 S R 40 E C-09

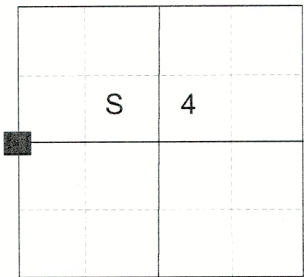

DESCRIPTION OF CORNER EVIDENCE FOUND:

None found. Remnants of North/South fence exist in the area, exact location indeterminate

DESCRIPTION OF MONUMENT AND ACCESSORIES I ESTABLISHED TO MONUMENT THE ORIGINAL LOCATION OF THIS CORNER:

At proportionate position I set a 2 1/2" x 30" aluminum pipe, 28" in the ground and in a 2 ft. collar of stone, with 3" aluminum cap marked as shown below, from which:


NEW BEARING OBJECTS:

A 5/8" x 15" iron pin bears North 44°09' East, a distance of 18.72 feet, with 1 1/2" aluminum cap marked BGB SURVEY MARKER NE RP
A 15" Ponderosa Pine bears South 29° East, a distance of 23.35 feet, marked 1/4 S4 BT
An 11" Ponderosa Pine bears South 32° West, a distance of 22.70 feet, marked 1/4 S5 BT
A 5/8" x 15" iron pin bears North 47°48' West, a distance of 16.66 feet, with 1 1/2" aluminum cap marked BGB SURVEY MARKER NW RP

Set steel fence post approx. 1 ft. North

I hereby certify that the corner was monumented on May 28, 2025

Witness: Kyle Tucker

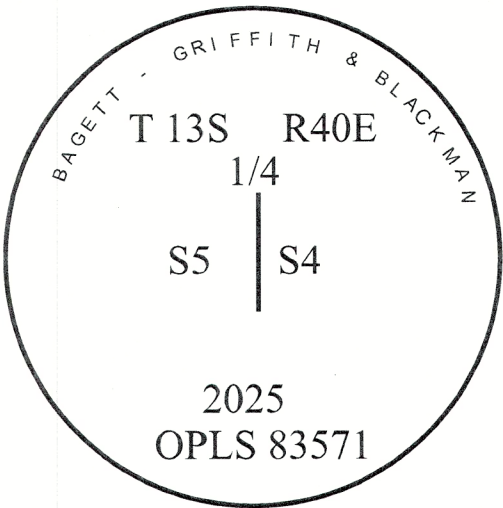

Renewal Date: June 30, 2027

I use a tape and compass in the establishment of the new bearing trees 14° East was used for declination and measured to a brass washer labeled "OPLS 83571" in the BT blaze at the base of the tree. Distances are to a 60D nail in the right wide of the base of the center of the tree. I used a Leica GS-18 with RTK in the establishment of the iron pin accessories. Basis of bearing is as per the Oregon Coordinate Reference System Baker Zone. Bearings and distances are measured to the center of the aluminum caps.

C-09

FILED June 25, 2025
BAKER COUNTY SURVEYOR
CLAYVE NO. 13-40-11