


CERTIFIED RECORD OF LAND CORNER MONUMENTATION

HISTORY OF ORIGINAL CORNER ESTABLISHED:

Corner was originally established under GLO contract number 148, dated May 17th, 1871, executed by John S. Kincaid. Surveyor General field notes state:

Set stone 17x10x8 for 1/4 sec. cor.

T 13 S R 40 E C-13

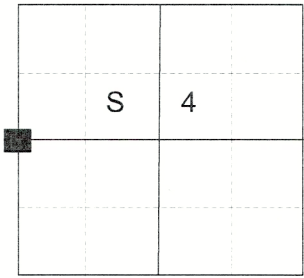

DESCRIPTION OF CORNER EVIDENCE FOUND:

Found an old fence corner from which juniper posts and downed barbed wire run South. In this vicinity I found broken rock with chisel marks "1/". When found pieces were assembled it forms a stone measuring 18" x 12" x 10".

DESCRIPTION OF MONUMENT AND ACCESSORIES I ESTABLISHED TO MONUMENT THE ORIGINAL LOCATION OF THIS CORNER:

At position of found fence corner I set a 2 1/2" x 30" aluminum pipe, 28" in the ground and in a 1 ft. collar of stone, with 3" aluminum cap marked as shown below, from which:


NEW BEARING OBJECTS:

- A 5/8" x 15" iron pin bears North 37°26' East, a distance of 13.01 feet, with 1 1/2" aluminum cap marked BGB SURVEY MARKER NE RP
- A 5/8" x 15" iron pin bears South 45°19' East, a distance of 21.58 feet, with 1 1/2" aluminum cap marked BGB SURVEY MARKER SE RP
- A 5/8" x 15" iron pin bears South 44°03' West, a distance of 19.28 feet, with 1 1/2" aluminum cap marked BGB SURVEY MARKER SW RP
- A 5/8" x 15" iron pin bears North 59°01' West, a distance of 15.87 feet, with 1 1/2" aluminum cap marked BGB SURVEY MARKER NW RP

Buried stone remnants along North side of monument
Set steel fence post approx. 1 ft. North

I hereby certify that the corner was monumented on May 28, 2025

Witness: Kyle Tucker

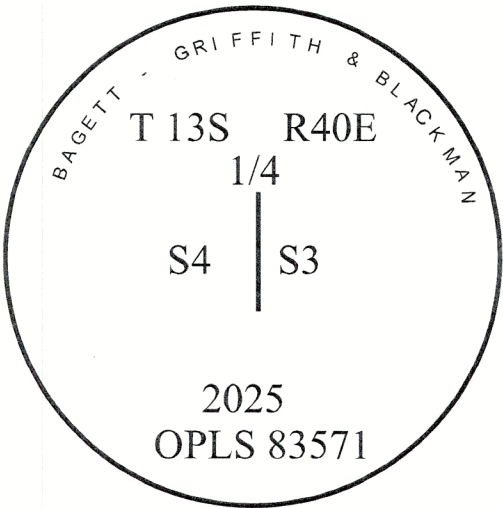

Renewal Date: June 30, 2027

I use a Leica GS18 with RTK in the establishment of the new bearing objects. Basis of Bearing is as per the "Oregon Coordinate Reference System Baker Zone". Bearings and distances are measured to the center of the aluminum caps.

C-13

FILED June 25, 2025
BAKER COUNTY SURVEYOR
SURVEY NO. 13-40-12