


CERTIFIED RECORD OF LAND CORNER MONUMENTATION

HISTORY OF ORIGINAL CORNER ESTABLISHED:
Corner not previously established.

T 13 S R 40 E C-14

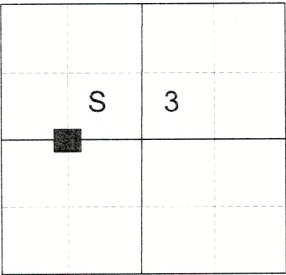

DESCRIPTION OF CORNER EVIDENCE FOUND:
None.

DESCRIPTION OF MONUMENT AND ACCESSORIES I ESTABLISHED TO MONUMENT THE
ORIGINAL LOCATION OF THIS CORNER:

At position by survey, I set a 5/8" x 30" iron pin, 25" in the ground, with 2 1/2" aluminum cap marked as shown below, from which:

NEW BEARING OBJECTS:

A 5/8" x 15" iron pin bears North 45°41' East, a distance of 12.83 feet, with 1 1/2" aluminum cap marked BGB SURVEY MARKER N RP


A 5/8" x 15" iron pin bears South 12°34' East, a distance of 12.68 feet, with 1 1/2" aluminum cap marked BGB SURVEY MARKER S RP

Set steel fence post approx. 0.5 ft. Southeasterly

Ancient fence corner to North/West bearing fence lines bears approx. 47 feet North.

I hereby certify that the corner was monumented on June 4, 2025

Witness: Kyle Tucker

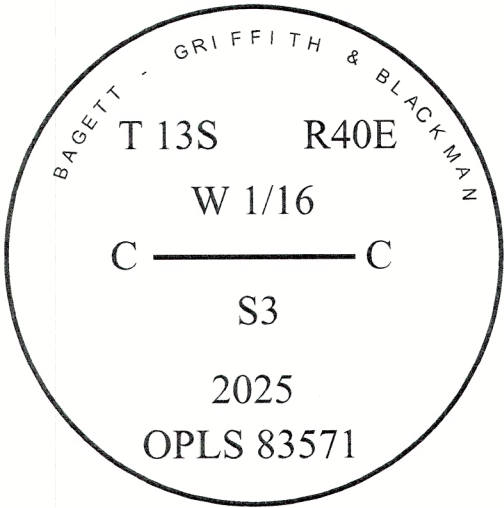

Renewal Date: June 30, 2027

I used a Leica GS18 with RTK in the establishment of the new bearing objects. Basis of Bearing is as per the "Oregon Coordinate Reference System Baker Zone". Bearings and distances are measured to the center of the aluminum caps.

C-14

FILED June 25, 2025
BAKER COUNTY SURVEYOR
SURVEY NO. 13-40-13