


CERTIFIED RECORD OF LAND CORNER MONUMENTATION

HISTORY OF ORIGINAL CORNER ESTABLISHED:

Corner was originally established under GLO contract number 148, dated May 17th, 1871, executed by John S. Kincaid. Surveyor General field notes state:

Set stone 17x10x8 for 1/4 sec. cor.

T 13 S R 40 E E-11

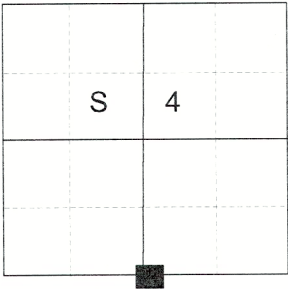

DESCRIPTION OF CORNER EVIDENCE FOUND:

There are several stone of called size in this area, though no marks could be found on any. Nor are there any embedded stone mounds that could be differentiated from natural stone outcrops. A 34" Ponderosa Pine with wire running through the center of it falls in this area, with remnants of barbed wire heading North.

DESCRIPTION OF MONUMENT AND ACCESSORIES I ESTABLISHED TO MONUMENT THE ORIGINAL LOCATION OF THIS CORNER:

At a position on line between the Section Corners, and at an Easting position in line with the Ponderosa Pine, I set a 2 1/2" x 30" aluminum pipe, 18" in the ground and in a 3 ft. mound of stone, with 3" aluminum cap marked as shown below, from which:


NEW BEARING OBJECTS:

- A 5" Juniper bears North 31° East, a distance of 78.70 feet, marked 1/4 S4 BT
- A 10" Ponderosa Pine bears South 76° East, a distance of 40.80 feet, marked 1/4 S9 BT
- A 34" Ponderosa bears South 7° West, a distance of 6.30 feet, marked 1/4 S9 BT
- A 3" Ponderosa Pine bears North 26° West, a distance of 29.45 feet, marked X BT

Set steel fence post approx. 1 ft. West

I hereby certify that the corner was monumented on May 28, 2025

Witness: Kyle Tucker

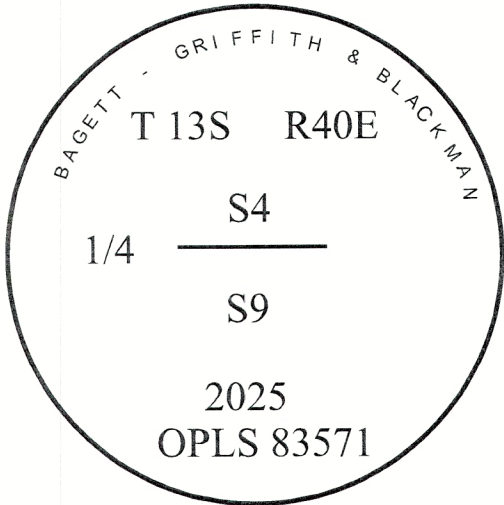

Renewal Date: June 30, 2027

I use a tape and compass in the establishment of the new bearing objects. 14° East was used for declination and measured to a brass washer labeled "OPLS 83571" in the BT blaze at the base of the tree. Distances are to a 60D nail in the right wide of the base of the center of the tree.

E-11

FILED June 25, 2025
BAKER COUNTY SURVEYOR
SURVEY NO. 13-40-17