


CERTIFIED RECORD OF LAND CORNER MONUMENTATION

HISTORY OF ORIGINAL CORNER ESTABLISHED:

Corner was originally established under GLO contract number 148, dated May 17th, 1871, executed by John S. Kincaid.
Surveyor General field notes state:

Set stone 18x10x7 for 1/4 sec. cor.

T 13 S R 40 E E-15

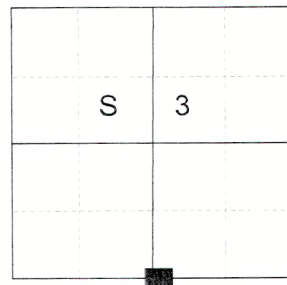

DESCRIPTION OF CORNER EVIDENCE FOUND:

Found stone 16" x 10" x 6" marked "1/4"

DESCRIPTION OF MONUMENT AND ACCESSORIES I ESTABLISHED TO MONUMENT THE ORIGINAL LOCATION OF THIS CORNER:

At position of found stone, I set a 2 1/2" x 30" aluminum pipe, set 18" in the ground and in a 3 ft. diam. mound of stone, with 3" aluminum cap marked as shown below, from which:


NEW BEARING OBJECTS:

A 5/8" x 15" iron pin bears North 73°50 East, a distance of 7.60, with 1 1/2" aluminum cap marked NE RP
A 5/8" x 15" iron pin bears South 25°52 East, a distance of 12.58, with 1 1/2" aluminum cap marked SE RP
A 5/8" x 15" iron pin bears South 50°04 West, a distance of 14.53, with 1 1/2" aluminum cap marked SW RP
A 5/8" x 15" iron pin bears North 15°60 West, a distance of 15.05, with 1 1/2" aluminum cap marked NW RP

Set steel fence post approx. 1.5 ft. West
Buried stone alongside North edge of monument

I hereby certify that the corner was monumented on June 4, 2025

Witness: Kyle Tucker

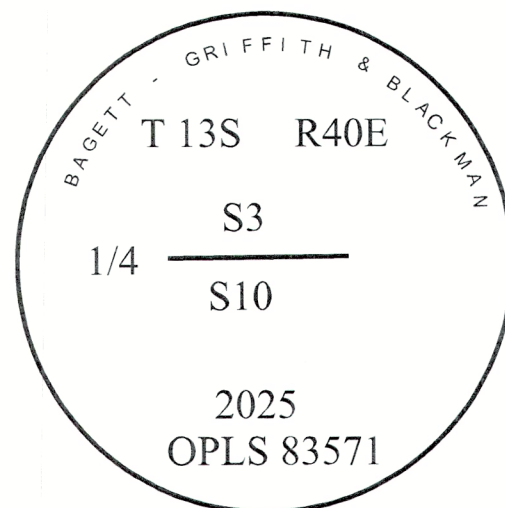

Renewal Date: June 30, 2027

I use a Leica GS18 with RTK in the establishment of the new bearing objects. Basis of Bearing is as per the "Oregon Coordinate Reference System Baker Zone". Bearings and distances are measured to the center of the aluminum caps.

E-15

FILED June 25, 2025
BAKER COUNTY SURVEYOR
SURVEY NO. 13-40-19