


CERTIFIED RECORD OF LAND CORNER MONUMENTATION

HISTORY OF ORIGINAL CORNER ESTABLISHED:

Corner was originally established under GLO contract number 148, dated May 17th, 1871, executed by John S. Kincaid. Surveyor General field notes state:

Set stone 17x14x7 for cor. to secs. 10, 11, 2, + 3,

T 13 S R 40 E E-17

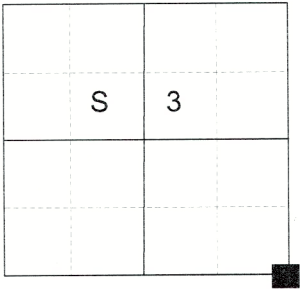

DESCRIPTION OF CORNER EVIDENCE FOUND:

Found stone 18" x 14" x 9" marked with 2 clear notches and in an area otherwise devoid of stones.

DESCRIPTION OF MONUMENT AND ACCESSORIES I ESTABLISHED TO MONUMENT THE ORIGINAL LOCATION OF THIS CORNER:

At position of found stone, I set a 2 1/2" x 30" aluminum pipe, set 18" in the ground and in a 3 ft. diam. mound of stone, with 3" aluminum cap marked as shown below, from which:


NEW BEARING OBJECTS:

- A 5/8" x 15" iron pin bears North 23°33' East, a distance of 13.42 ft., with 1 1/2" aluminum cap marked NE RP
- A 5/8" x 15" iron pin bears South 48°44' East, a distance of 9.23 ft., with 1 1/2" aluminum cap marked SE RP
- A 5/8" x 15" iron pin bears South 39°23' West, a distance of 10.26 ft., with 1 1/2" aluminum cap marked SW RP
- A 5/8" x 15" iron pin bears North 46°49' West, a distance of 18.54 ft., with 1 1/2" aluminum cap marked NW RP

Set steel fence post approx. 1 ft. South
Buried stone alongside South side of monument

I hereby certify that the corner was monumented on June 4, 2025

Witness: Kyle Tucker

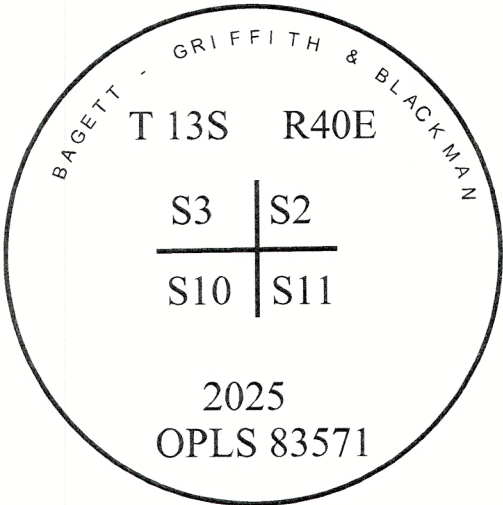

Renewal Date: June 30, 2027

I use a Leica GS18 with RTK in the establishment of the new bearing objects. Basis of Bearing is as per the "Oregon Coordinate Reference System Baker Zone". Bearings and distances are measured to the center of the aluminum caps.

E-17

FILED June 25, 2025
BAKER COUNTY SURVEYOR
SURVEY NO. 13-40-20