


CERTIFIED RECORD OF LAND CORNER MONUMENTATION

HISTORY OF ORIGINAL CORNER ESTABLISHED:

Corner was originally established under GLO contract number 148, dated May 17th, 1871, executed by John S. Kincaid. Surveyor General field notes state:

Set stone 14x10x7 for 1/4 sec. cor.

T 13 S R 40 E G-09

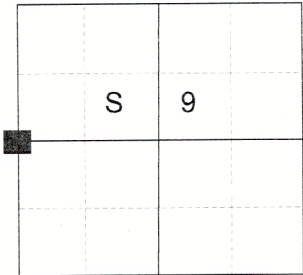

DESCRIPTION OF CORNER EVIDENCE FOUND:

None. Area is devoid of stone.

DESCRIPTION OF MONUMENT AND ACCESSORIES I ESTABLISHED TO MONUMENT THE ORIGINAL LOCATION OF THIS CORNER:

At proportionate position, I set a 2 1/2" x 30" aluminum pipe, 28" in the ground, with 3" aluminum cap marked as shown below, from which:


NEW BEARING OBJECTS:

- A 5/8" x 15" iron pin bears North 52°29' East, a distance of 22.30 feet, with 1 1/2" aluminum cap marked BGB SURVEY MARKER NE RP
- A 5/8" x 15" iron pin bears South 30°06' East, a distance of 14.91 feet, with 1 1/2" aluminum cap marked BGB SURVEY MARKER SE RP
- A 5/8" x 15" iron pin bears South 74°03' West, a distance of 17.84 feet, with 1 1/2" aluminum cap marked BGB SURVEY MARKER SW RP
- A 5/8" x 15" iron pin bears North 23°28' West, a distance of 25.11 feet, with 1 1/2" aluminum cap marked BGB SURVEY MARKER NW RP

Set steel fence post approx. 1 ft. South

I hereby certify that the corner was monumented on June 3, 2025

Witness: Kyle Tucker

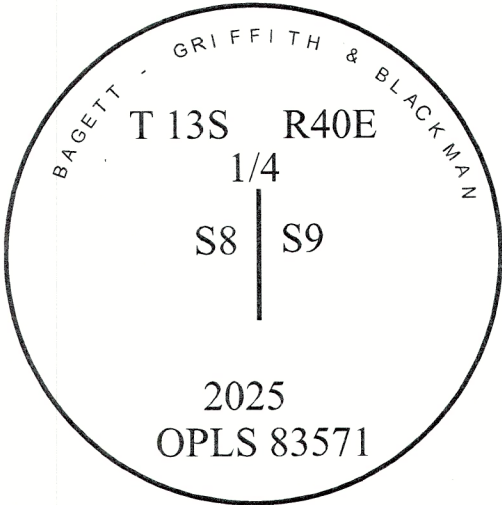

Renewal Date: June 30, 2027

I use a Leica GS18 with RTK in the establishment of the new bearing objects. Basis of Bearing is as per the "Oregon Coordinate Reference System Baker Zone". Bearings and distances are measured to the center of the aluminum caps.

G-09

FILED June 25, 2025
BAKER COUNTY SURVEYOR
SURVEY NO. 13-40-25