


CERTIFIED RECORD OF LAND CORNER MONUMENTATION

HISTORY OF ORIGINAL CORNER ESTABLISHED:

Corner was originally established under GLO contract number No. 148, dated May 17th, 1871, executed by John S. Kincaid. Surveyor General field notes state:

Set stone 18x14x5 for cor. to secs. 16, 17, 8, + 9

T 13 S R 40 E J-09

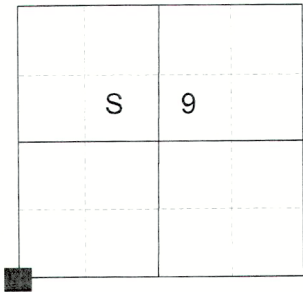

DESCRIPTION OF CORNER EVIDENCE FOUND:

Found an embedded mound of stone approx. 5 ft. West of an old North/South running fence line. 3 stones in the mound are close to the called size but I find no discernible marks. Falls harmoniously with the section corner to the North and with the topo calls to the North.

DESCRIPTION OF MONUMENT AND ACCESSORIES I ESTABLISHED TO MONUMENT THE ORIGINAL LOCATION OF THIS CORNER:

At center of found mound of stone, I set a 2 1/2" x 30" aluminum pipe, 28" in the ground and in a 4 ft. diam. collar of stone, with 3" aluminum cap marked as shown below, from which:


NEW BEARING OBJECTS:

- A 25" Ponderosa Pine bears North 12° East, a distance of 24.55 feet, marked T13S R40E S9 BT
- A 6" Ponderosa Pine bears South 82° East, a distance of 42.80 feet, marked T13S R40E S16 BT
- A 6" Ponderosa Pine bears South 6° West, a distance of 17.65 feet, marked T13S R40E S17 BT
- A 6" Ponderosa Pine bears North 67° West, a distance of 37.45 feet, marked T13S R40E S8 BT

Set steel fence post approx. 1 ft. West

I hereby certify that the corner was monumented on June 3, 2025

Witness: Kyle Tucker

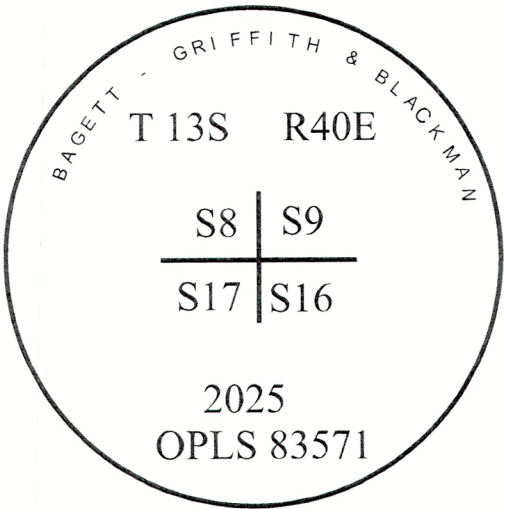

Renewal Date: June 30, 2027

I use a tape and compass in the establishment of the new bearing objects. 14° East was used for declination and measured to a brass washer labeled "OPLS 83571" in the BT blaze at the base of the tree. Distances are to a 60D nail in the right wide of the base of the center of the tree.

J-09

FILED June 25 2025
BAKER COUNTY SURVEYOR
SURVEY NO. 13-40-29