


CERTIFIED RECORD OF LAND CORNER MONUMENTATION

HISTORY OF ORIGINAL CORNER ESTABLISHED:

Corner was originally established under GLO contract number 148, dated May 17th, 1871, executed by John S. Kincaid. Surveyor General field notes state:

Set stone 14x12x10 for 1/4 sec. cor.

T 13 S R 40 E J-11

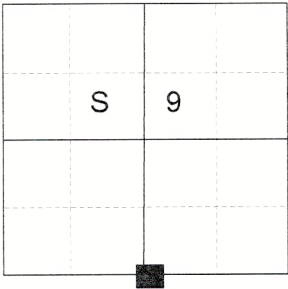

DESCRIPTION OF CORNER EVIDENCE FOUND:

None.

DESCRIPTION OF MONUMENT AND ACCESSORIES I ESTABLISHED TO MONUMENT THE ORIGINAL LOCATION OF THIS CORNER:

At proportionate position, I set a 2 1/2" x 30" aluminum pipe, 22" in the ground and in a 2 ft. diam. mound of stone, with 3" aluminum cap marked as shown below, from which:



NEW BEARING OBJECTS:

A 5/8" x 15" iron pin bears North 55°49 East, a distance of 17.36, with 1 1/2" aluminum cap marked NE RP
A 5/8" x 15" iron pin bears South 32°01 East, a distance of 12.90, with 1 1/2" aluminum cap marked SE RP
A 5/8" x 15" iron pin bears South 65°47 East, a distance of 16.53, with 1 1/2" aluminum cap marked SW RP
A 5/8" x 15" iron pin bears North 35°22 East, a distance of 22.70, with 1 1/2" aluminum cap marked NW RP

Set steel fence post approx. 1 ft. East

I hereby certify that the corner was monumented on June 3, 2025

Witness: Kyle Tucker

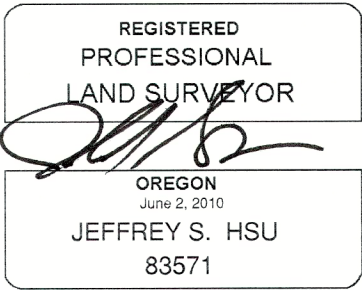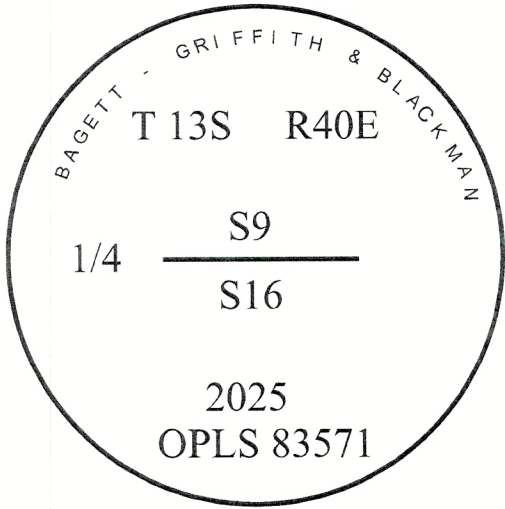

Renewal Date: June 30, 2027

I use a tape and compass in the establishment of the new bearing objects. 14° East was used for declination and measured to a brass washer labeled "OPLS 83571" in the BT blaze at the base of the tree. Distances are to a 60D nail in the right wide of the base of the center of the tree.

J-11

FILED June 25, 2025
BAKER COUNTY SURVEYOR
SURVEY NO. 13-40-30