


CERTIFIED RECORD OF LAND CORNER MONUMENTATION

HISTORY OF ORIGINAL CORNER ESTABLISHED:

Corner was originally established under GLO contract number 148, dated May 17th, 1871, executed by John S. Kincaid. Surveyor General field notes state:

Set stone 18x10x9 for cor. to secs. 15, 16, 9, + 10

T 13 S R 40 E J-13

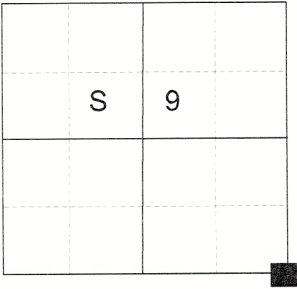

DESCRIPTION OF CORNER EVIDENCE FOUND:

A barbed wire fence bears North/South, with remnants of an older wood fence lying alongside. Rock jacks exist with many stones of called size but none with discernible marks

DESCRIPTION OF MONUMENT AND ACCESSORIES I ESTABLISHED TO MONUMENT THE ORIGINAL LOCATION OF THIS CORNER:

At position by survey, I set a 2 1/2" x 30" aluminum pipe, 18" in the ground and in a 3 ft. diam. mound of stone, with 3" aluminum cap marked as shown below, from which:


NEW BEARING OBJECTS:

A 5/8" x 15" iron pin bears North 33°21 East, a distance of 12.76, with 1 1/2" aluminum cap marked NE RP
A 5/8" x 15" iron pin bears South 40°02 East, a distance of 15.90, with 1 1/2" aluminum cap marked SE RP
A 5/8" x 15" iron pin bears South 55°11 West, a distance of 15.47, with 1 1/2" aluminum cap marked SW RP
A 5/8" x 15" iron pin bears North 35°05 West, a distance of 15.47, with 1 1/2" aluminum cap marked NW RP

Set steel fence post approx. 1.5 ft. South

I hereby certify that the corner was monumented on June 5, 2025

Witness: Kyle Tucker

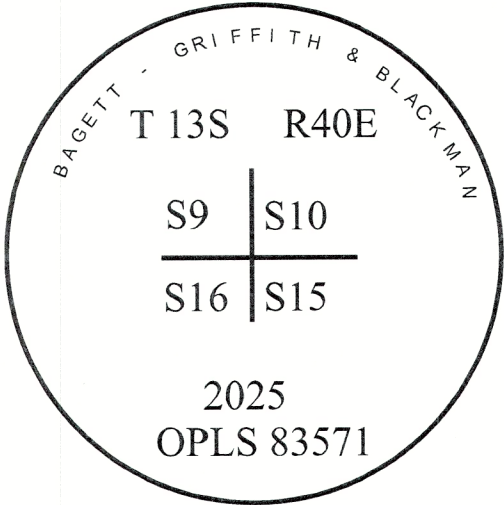

Renewal Date: June 30, 2027

I use a Leica GS18 with RTK in the establishment of the new bearing objects. Basis of Bearing is as per the "Oregon Coordinate Reference System Baker Zone". Bearings and distances are measured to the center of the aluminum caps.

J-13

FILED June 25, 2025
BAKER COUNTY SURVEYOR
SURVEY NO. 13-40-31