


CERTIFIED RECORD OF LAND CORNER MONUMENTATION

HISTORY OF ORIGINAL CORNER ESTABLISHED:

Corner was originally established under GLO contract number 409, dated August 22nd, 1881, executed by George Henderson. Surveyor General field notes state:

Drove yellow pine post 3 ft. long and 2 1/2 ins. sqr. for 1/4 sec cor marked 1/4 S on W. side, dug pits 20x12x10 ins. E and W. of post 5 ft. dist. and raised mound of earth 2 ft. high and 2 1/2 ft. diam at base around post.

T 13 S R 40 E X-09

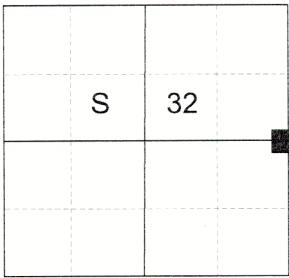

DESCRIPTION OF CORNER EVIDENCE FOUND:


Found a degraded mound of stone in an area otherwise devoid of stone in an East/West fence line

DESCRIPTION OF MONUMENT AND ACCESSORIES I ESTABLISHED TO MONUMENT THE ORIGINAL LOCATION OF THIS CORNER:

At position of stone mound, I set a 2 1/2" aluminum pipe, 24" in the ground and in a 2 1/2 ft. diam. mound of stone, with 3" aluminum cap marked as shown below, from which:

NEW BEARING OBJECTS:

- A 3" Double bole Juniper bears North 20°30' East, a distance of 45.80 feet, marked 1/4 S33 BT.
- A 5" Juniper bears East, a distance of 47.50 feet, marked 1/4 S33 BT.
- A 27" Ponderosa Pine bears South 48°30' West, a distance of 134.25 feet, marked 1/4 S32 BT
- A 6" Juniper bears North 40° West, a distance of 67.70 feet, marked 1/4 S32 BT

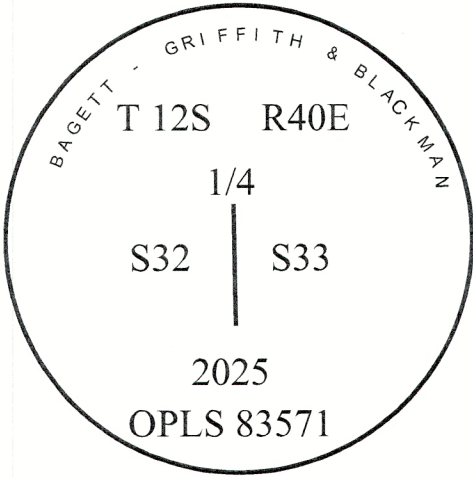

I hereby certify that the corner was monumented on May 6, 2025

Witness: Kyle Tucker

REGISTERED
PROFESSIONAL
LAND SURVEYOR

OREGON
June 2, 2010
JEFFREY S. HSU
83571

Renewal Date: June 30, 2027

I use a tape and compass in the establishment of the new bearing objects. 14° East was used for declination and measured to a brass washer labeled "OPLS 83571" in the BT blaze at the base of the tree. Distances are to a 60D nail in the right side of the base of the center of the tree.

X-09

FILED June 25, 2025
BAKER COUNTY SURVEYOR
SURVEY NO. 13-40-32