
T. 13 S., R. 42 E., W.M. SI/2; EI/2 NEI/4, Sec. 23

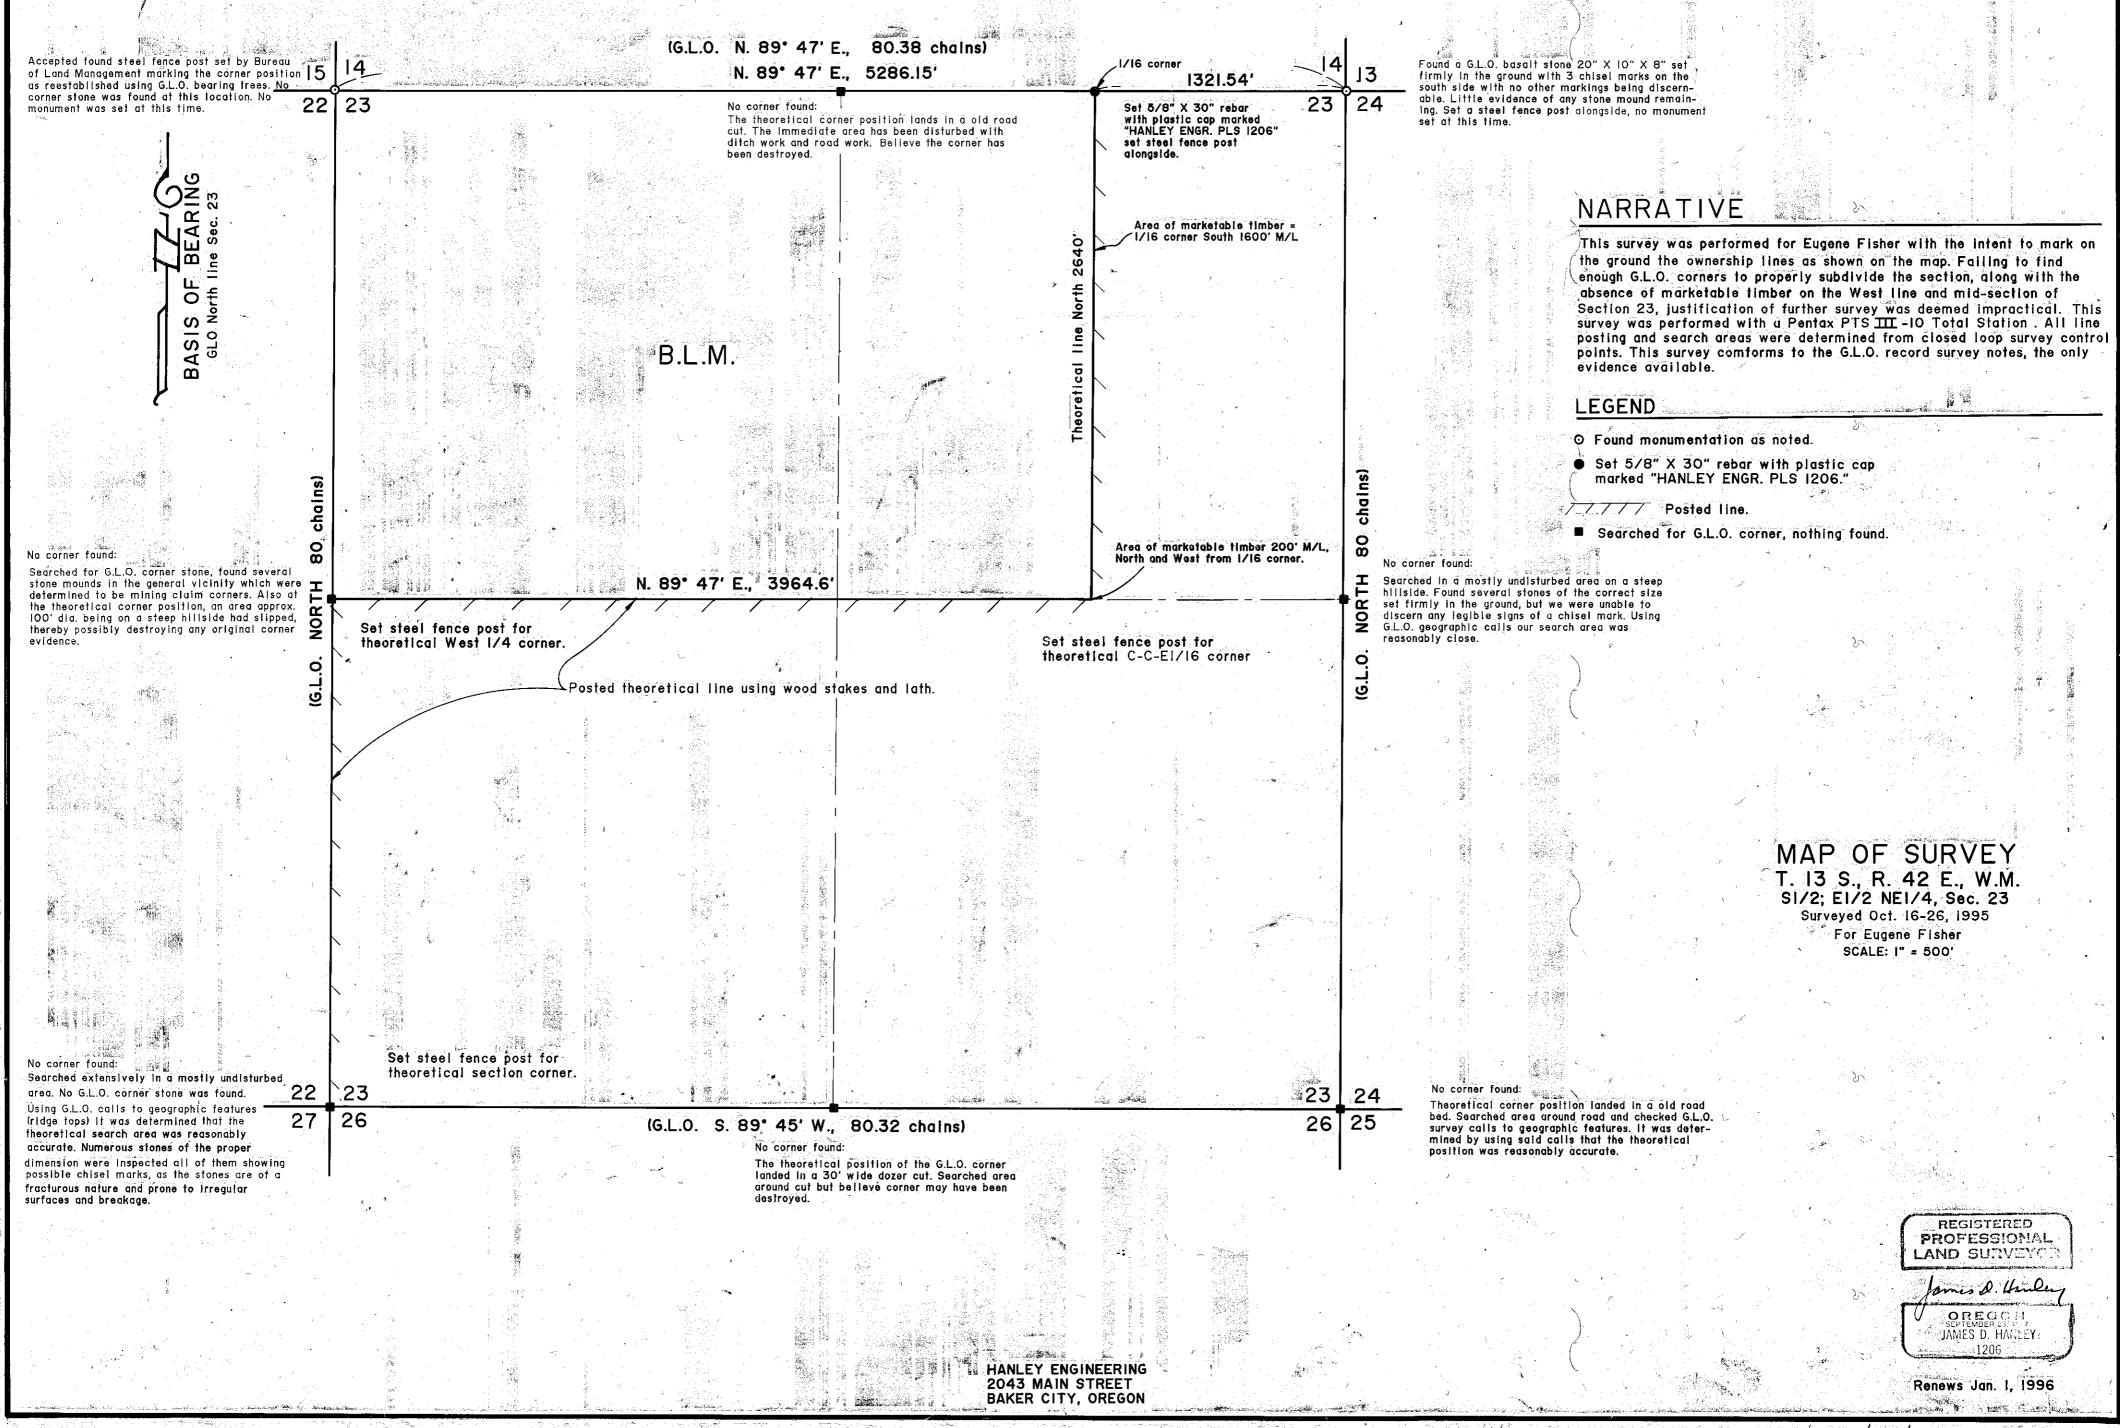

FILED 12/4/195


BAKER COUNTY SURVEYOR
SURVEY NO 13-42-1