

26

RM NO. 1 MKD:


RM NO. 2 MKD:

RM
W CEN END
WINDY NO. 1
← 91.75'
CS 1975

RM
SW COR
WINDY NO. 1
← 209.0'
CS 1975

LEGEND

- Indicates found 2" pipe.
- Indicates set 2 1/2" brass cap on 1" galv. iron post.

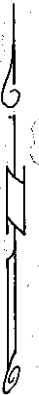

South line of Sec. 26 N. 89° 52' E,
from Philo H. Anderson map of
Marble Claims, 1951.



MAP OF SURVEY WINDY CLAIM NO. 1

IN THE SE 1/4 SW 1/4 SEC. 26, T. 13 S., R. 44 E., W.M.

Surveyed July 18 & 21, 1975
Aug. 8, 1975

Scale 1" = 500'

For Oregon Portland Cement Co.

FILED 8-25-75
BAKER COUNTY SURVEYOR
SURVEY NO. 13-44-3

