

GOVERNMENT CORNER RECORD

Township 13S Range 44E Section $\frac{33}{4}$ County BAKER

State OREGON Date 6/23/11 Number A-11

Corner Designation : 1/4 CORNER $\frac{33}{4}$

- Condition Report Only
- Not Found
- Renewed
- Surveyed In
- Reference


Previous Renewals _____

Monument(s) Found: (Condition and Source)

B.L.M BRASS CAP, ON HILLSIDE WITH MOUND OF STONE

MONUMENT DETAIL

Found Set

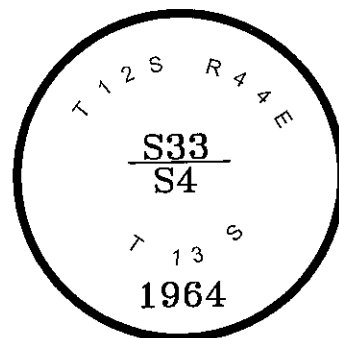


Accessories Found:

NONE

Monument & Accessories Set (Procedure and Description)

NONE

Sketch of Monument, Accessories and General Area

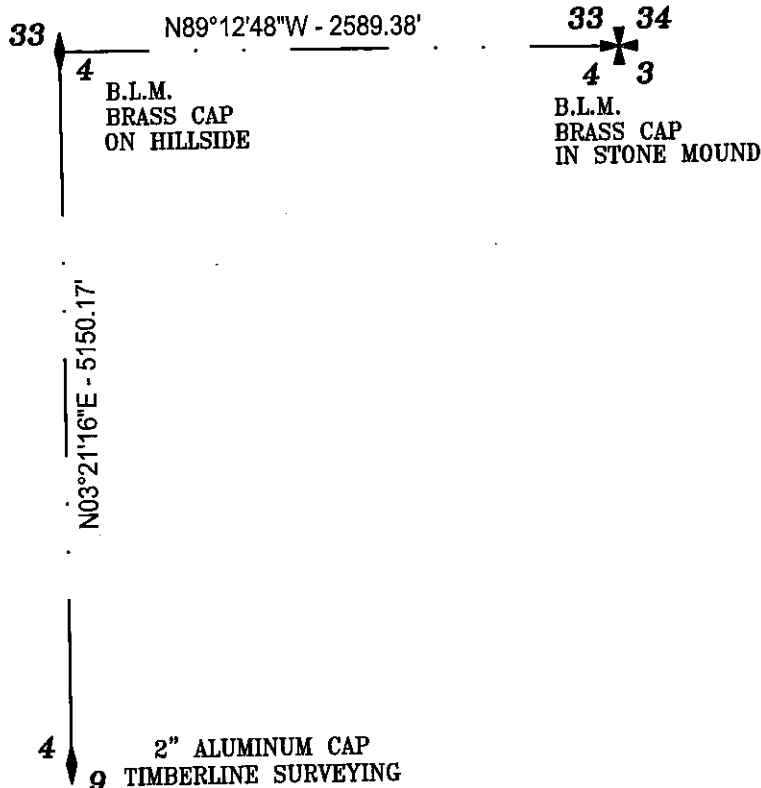

Surveyor's Seal

REGISTERED
PROFESSIONAL
LAND SURVEYOR

Russell Badgley
7/29/11

OREGON
NOVEMBER 13, 2007
RUSSELL BADGLEY
70716 LS

RENEWAL DATE : 12-31-11

Agency TIMBERLINE SURVEYING

Party Chief M. FEMENIA

Notekeeper _____

Witness(s) _____

COUNTY SURVEYOR RECORDING INFO

Received _____

Filed Aug. 1, 2011

Survey No. 12-44-15
13-44-24

Drawing No. _____

Index No. _____