


CERTIFIED RECORD OF LAND CORNER MONUMENTATION

HISTORY OF ORIGINAL CORNER ESTABLISHMENT:

This corner was never established.


N16

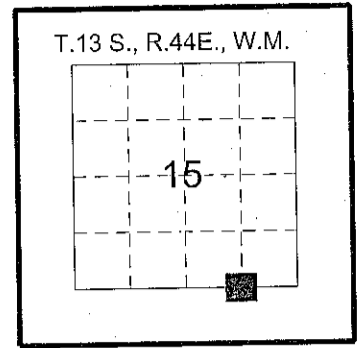

DESCRIPTION OF CORNER EVIDENCE FOUND:

DESCRIPTION OF MONUMENT AND ACCESSORIES I ESTABLISHED TO PERPETUATE THE ORIGINAL LOCATION OF THIS CORNER:

Set a 5/8 inch diameter by 30 inches long iron rod (rebar) with 3 1/4 inches diameter aluminum cap, driven 30 inches in the ground, with rock collar, marked as shown. A galvanized steel post placed north 3 feet.

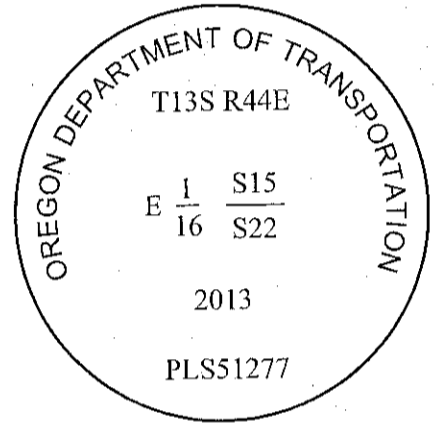

From which I establish the following references:

A + (cross) chiseled into large boulder, 4.5 ft. by 3.5 ft. by 2.5 ft. high, embedded in slope, with "BO" chiseled into face below said mark, boulder sits above old stage road (gravel), Bears N.12° 45'50"E., 92.54 feet.

A found 5/8 inch diameter iron rod (smooth), down in hole in large sized talus rock at top of slope above Powell Creek, Bears S.87° 40'39"W., 330.34 feet.

NOTE: This iron rod was set circa. 1959 for a parcel that was intended to be acquired by the state but was never purchased. A 4" by 4" wood post is nearby, (sw'ly 0.5 ft.).

The section line between sections 15 and 22 bears north, 6.68 feet from this monument.

REGISTERED
PROFESSIONAL
LAND SURVEYOR

OREGON
JULY 13, 1999
PETER C. ELDER
51277

RENEWS: 12/31/2015

Accessories taken using a Leica GS14 survey grade GNSS system, bearings checked with hand compass set at 19° East declination. Corner sits below old stage road (gravel), bears west and about 6 feet vertical.

Witnesses: Ross Hodgson, Peter Elder

I hereby certify that the above corner position was perpetuated as hereon described on December 12, 2013.

FILED Aug. 5, 2014
BAKER COUNTY SURVEYOR
SURVEY NO. 13-44-34

	Section	Weatherby - Lime		
	Highway	Interstate 84, Old Oregon Trail		
	County	Baker	Scale	NTS
	Purpose	Quarry	Date	April 21, 2014
	File			