


CERTIFIED RECORD OF LAND CORNER MONUMENTATION

HISTORY OF ORIGINAL CORNER ESTABLISHMENT:

This corner was never established.


M15

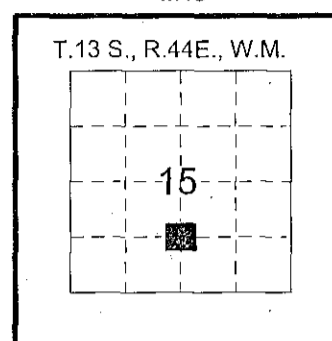

DESCRIPTION OF CORNER EVIDENCE FOUND:

DESCRIPTION OF MONUMENT AND ACCESSORIES ESTABLISHED TO PERPETUATE THE ORIGINAL LOCATION OF THIS CORNER:

Set a 5/8 inch diameter by 30 inch long iron rod (rebar), down 6 inches in rocky ground, the bottom 2 1/2 inches cemented into a 5/8 inch diameter drill hole, with 3 1/4 inch diameter aluminum cap marked as shown.
Placed a mound of stone around with 3 ft. base and 20 inches high, a galvanized steel post placed south, 2 feet.

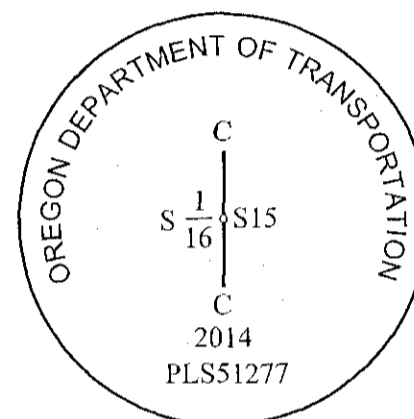

From which I establish the following references:

A pink DEEP-1 magnet, buried 2 inches in the ground, bears S. 67° E.; 5.30 ft.

A blue DEEP-1 magnet, buried 3 inches in the ground, bears S. 28° W., 5.75 ft.

NOTE: Corner falls on excavated rock bench at top of steep cliff, edge of cliff bears west 18 ft.

REGISTERED
PROFESSIONAL
LAND SURVEYOR

OREGON
JULY 13, 1999
PETER C. ELDER
51277

RENEWS: 12/31/2015

Accessories taken using a hand compass set at 19° East declination for bearings, and distance by steel tape.

Witness: Peter Elder

I hereby certify that the above corner position was perpetuated as hereon described on August 28, 2014.

FILED Sept. 16, 2014

BAKER COUNTY SURVEYOR

SURVEY NO. 13-44-35

OREGON DEPARTMENT OF TRANSPORTATION



RIGHT OF WAY
ENGINEERING
MONUMENTATION RECORD

Section	Weatherby - Lime		
Highway	Interstate 84, Old Oregon Trail		
County	Baker	Scale	NTS
Purpose	Quarry	Date	August 29, 2014
File			