


SEC.22 AND SUBDIVISION OF SEC.15, T.13S. R.44E., W.M. -MONUMENTS DETAIL


<p>①</p>  <p>FOUND A 3 1/4 INS. DIAM. ALUMINUM CAP ON A 5/8 IN. DIAM. IRON ROD, IN A MOUND OF STONE WITH 3 FT. BASE AND 1 FT. HIGH, ON SLOPE APPROXIMATELY 500 FT. ABOVE HIGHWAY, AS PER BAKER COUNTY SURVEY NOS. 13-44-15 & 13-45-10, MARKED AS SHOWN.</p>	<p>⑨</p>  <p>CORNER NOT FOUND, SET BY PROPORTIONATE MEASUREMENT. SET A 3 1/4 INS. DIAM. ALUMINUM CAP ON A 2 1/2 INS. DIAM. BY 30 INS. LONG ALUM. POST, BURIED 27 INS. IN THE GROUND, WITH CLEAR DEEP-1 MAGNET AT BASE AND ROCK COLLAR, MARKED AS SHOWN, FROM WHICH:</p> <p>A 5/8 IN. DIAM. BY 30 IN. LONG IRON ROD WITH 1 1/2 IN. DIAM. ALUM CAP MRKD. ODOT NE, BEARS N. 59° E., 6.95 FT. A 5/8 IN. DIAM. BY 30 IN. LONG IRON ROD WITH 1 1/2 IN. DIAM. ALUM CAP MRKD. ODOT SE, BEARS S. 40° E., 8.08 FT. A 5/8 IN. DIAM. BY 30 IN. LONG IRON ROD WITH 1 1/2 IN. DIAM. ALUM CAP MRKD. ODOT SW, BEARS S. 39° W., 7.55 FT. A 5/8 IN. DIAM. BY 30 IN. LONG IRON ROD WITH 1 1/2 IN. DIAM. ALUM CAP MRKD. ODOT NW, BEARS N. 42° W., 8.20 FT. NOTE: ACCESSORIES TAKEN WITH HAND COMPASS SET AT 19° E. DECLINATION AND STEEL TAPE.</p>
<p>②</p>  <p>FOUND A 3 1/4 INS. DIAM. DOMED ALUMINUM CAP ON ALUMINUM POST, WITH ROCK COLLAR AND PARTIAL STONE MOUND BELOW ON SLOPE, ON WEST SIDE OF BURNT RIVER IN SMALL GROVE OF WALNUT TREES, AS PER BAKER CO. SURVEY NO. 13-44-7, MARKED AS SHOWN.</p>	<p>⑩</p>  <p>SET A 5/8 IN. DIAM. BY 30 INS. LONG IRON ROD WITH 1 1/2 INS. DIAM. ALUM. CAP MARKED AS SHOWN, DRIVEN 10 INS. INTO ROCKY GROUND, RAISED MOUND OF STONE 3 FT. BASE AND 20 INS. HIGH, A GALV. STEEL POST PLACED NORTH, 9.5 FT.</p> <p>⑪</p>  <p>SET A 5/8 IN. DIAM. BY 30 INS. LONG IRON ROD WITH 1 1/2 INS. DIAM. ALUM. CAP MARKED AS SHOWN, DRIVEN 17 INS. INTO ROCK TALUS, RAISED MOUND OF STONE 3 FT. BASE AND 15 INS. HIGH, A GALV. STEEL POST PLACED SOUTH, 4 FT.</p>
<p>③</p>  <p>FOUND A 3 1/4 INS. DIAM. DOMED ALUMINUM CAP ON ALUMINUM POST, UP 2 INS., WITH ROCK COLLAR, IN EAST WEST WIRE FENCE, WITH ORANGE CARSONITE POST 1 FT. NORTH, AS PER BAKER CO. SURVEY NO. 13-44-8, MARKED AS SHOWN.</p>	<p>⑬</p>  <p>SET A 3 1/4 INS. DIAM. ALUMINUM CAP ON A 5/8 IN. DIAM. BY 30 INS. LONG IRON ROD, DRIVEN 30 INS. IN THE GROUND, WITH ROCK COLLAR, MARKED AS SHOWN, FROM WHICH:</p> <p>A CLEAR DEEP-1 MAGNET, BURIED 12 INS. IN THE GROUND IN OLD WIRE FENCELINE, BEARS S. 2° W., 6.20 FT. A FOUND 1 1/4 IN. OUTSIDE DIAM. IRON PIPE, UP 14 INS. AND BENT TO SOUTHEAST, (MEASUREMENT TO BASE ON NORTH SIDE), BEARS S. 79° W., 84.10 FT.</p> <p>NOTE: ACCESSORIES TAKEN WITH HAND COMPASS SET AT 19° E. DECLINATION FOR BEARINGS, AND DISTANCE BY STEEL TAPE TO MAGNET AND GPS VECTOR FOR DISTANCE TO FOUND PIPE.</p>
<p>④</p>  <p>FOUND A 3 1/4 INS. DIAM. ALUMINUM CAP ON A 5/8 IN. DIAM. IRON ROD, DOWN 25 INS. IN SANDY LOAM SOIL IN CULTIVATED AREA NEAR OLD HOMESTEAD, AS PER BAKER COUNTY SURVEY NOS. 13-44-15 & 13-45-10, MARKED AS SHOWN.</p>	<p>⑭</p>  <p>SET A 3 1/4 INS. DIAM. ALUMINUM CAP ON A 5/8 IN. DIAM. BY 30 INS. LONG IRON ROD, DRIVEN 30 INS. IN THE GROUND, WITH ROCK COLLAR, MARKED AS SHOWN, FROM WHICH:</p> <p>A + (CROSS) WITH "BO" CHISELED INTO A LARGE BOULDER 4.5 FT. BY 3.5 FT. BY 2.5 FT. HIGH, BEARS N. 12°45'50" E., 92.54 FT. A 5/8 IN. DIAM. IRON ROD, NO CAP, DOWN IN HOLE IN LARGE TALUS ROCK ON SLOPE ABOVE POWELL CREEK, BEARS S.87°40'39"W., 330.34 FT., (A 4" BY 4" WOOD POST IS SW'LY 0.5 FT.).</p> <p>NOTE: ACCESSORIES TAKEN WITH LEICA GS14 GNSS SYSTEM, BEARINGS CHECKED WITH HAND COMPASS SET AT 19° E. DECLINATION. CORNER SITS BELOW GRAVEL ROAD, 6 FT. VERTICAL AND WEST.</p>
<p>⑤</p>  <p>FOUND A 3 1/4 INS. DIAM. ALUMINUM CAP ON A 2 1/2 INS. DIAM. ALUMINUM POST, IN A MOUND OF STONE 3 FT. BASE AND 1 FT. HIGH, 3 FT. WEST OF FENCE "T" CORNER N-S-E, AS PER BAKER CO. SURVEY NOS. 13-44-15 & 13-45-10, MARKED AS SHOWN.</p>	<p>⑮</p>  <p>SET A 3 1/4 INS. DIAM. ALUMINUM CAP ON A 2 1/2 INS. DIAM. BY 30 INS. LONG ALUM. POST, BURIED 20 INS. IN THE GROUND, WITH CLEAR DEEP-1 MAGNET AT BASE AND STONE MOUND, MARKED AS SHOWN, FROM WHICH:</p> <p>A SILVER DEEP-1 MAGNET, BURIED 6 INS., BEARS N. 38° E., 7.30 FT. A PINK DEEP-1 MAGNET, BURIED 6 INS., BEARS S. 60° E., 7.95 FT. A BLUE DEEP-1 MAGNET, BURIED 6 INS., BEARS S. 26° W., 7.25 FT. A ORANGE DEEP-1 MAGNET, BURIED 6 INS., BEARS N. 52° W., 6.15 FT. NOTE: ACCESSORIES TAKEN WITH HAND COMPASS SET AT 19° E. DECLINATION AND STEEL TAPE.</p>
<p>⑥</p>  <p>FOUND A 3 1/4 INS. DIAM. DOMED ALUMINUM CAP ON ALUMINUM POST, AT GROUND LEVEL WITH PARTIAL STONE MOUND BELOW ON SLOPE, ON WEST FACING SLOPE ABOVE LANGLEY LANE, AS PER BAKER CO. SURVEY NO. 13-44-10, MARKED AS SHOWN.</p>	<p>⑯</p>  <p>SET A 3 1/4 INS. DIAM. ALUMINUM CAP ON A 5/8 IN. DIAM. BY 30 INS. LONG IRON ROD, DOWN 6 INS. IN ROCKY GROUND, THE BOTTOM 2 1/2 INS. CEMENTED INTO A 5/8 IN. DIAM. DRILL HOLE, WITH MOUND OF STONE 3 FT. BASE, AND GALV. STEEL POST 2 FT. S., MARKED AS SHOWN, FROM WHICH:</p> <p>A PINK DEEP-1 MAGNET, BURIED 2 INS. IN ROCKY GROUND, BEARS S. 67° E., 5.30 FT. A BLUE DEEP-1 MAGNET, BURIED 3 INS. IN ROCKY GROUND, BEARS S. 28° W., 5.75 FT.</p> <p>ACCESSORIES TAKEN WITH HAND COMPASS SET AT 19° E. DECLINATION AND STEEL TAPE. NOTE: CORNER FALLS ON EXCAVATED ROCK BENCH AT TOP OF STEEP CLIFF, EDGE OF CLIFF BEARS WEST 18 FT.</p>
<p>⑦</p> <p>FOUND A 3/4 INS. DIAM. IRON ROD, UP 6 INS. IN A PARTIAL MOUND OF STONE (STONES HAVE SLID DOWNHILL), ON A SLOPE ON THE SOUTH SIDE AND JUST BELOW A SPUR RIDGE, AS PER BAKER COUNTY SURVEY NO. 13-44-0001, MARKED AS SHOWN.</p> <p>NOTE: STONES REPLACED AROUND CORNER, 3FT. BASE AND 1 FT. HIGH.</p>	<p>⑫</p>  <p>SET A 5/8 IN. DIAM. BY 30 INS. LONG IRON ROD WITH 1 1/2 INS. DIAM. ALUM. CAP, MARKED AS SHOWN, DRIVEN 23 INS. IN THE GROUND ON STEEP SLOPE, PLACED ROCK COLLAR AROUND AND GALV. STEEL POST NORTH, 4 FT.</p>

⑧

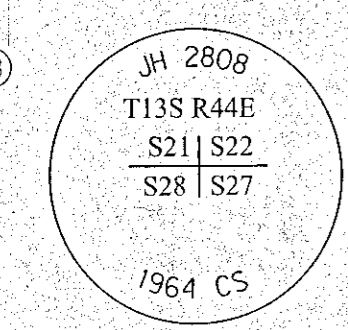

FOUND A 2 1/2 INS. DIAM. ALUMINUM CAP ON A 1 1/4 INS. OUTSIDE DIAM. GALV. IRON PIPE, UP 10 INS., WITH ROCK COLLAR, ON A NORTH FACING SLOPE, AS PER BAKER CO. SURVEY NO. 13-44-0001, MARKED AS SHOWN.

REGISTERED PROFESSIONAL LAND SURVEYOR

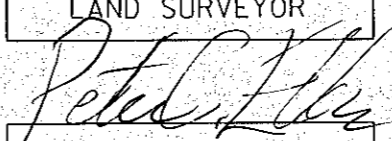

OREGON
JULY 13, 1999
PETER C. ELDER
51277

RENEWS: 12/31/2015

FILED January 30, 2015
BAKER COUNTY SURVEYOR
SURVEY NO. 13-44-37

OREGON DEPARTMENT OF TRANSPORTATION

SECTIONS 15 & 22, T.13S. R.44E. W.M.
SUBDIVISION AND SURVEY FOR
RYE VALLEY QUARRY
OLD OREGON TRAIL HIGHWAY, I-84
DURKEE-LIME SECTION, BAKER COUNTY

FOR ODOT REGION 5
3012 ISLAND AVENUE
LA GRANDE, OR 97850

JANUARY 28, 2015
SCALE: NTS
SHEET 2 OF 4