

GOVERNMENT CORNER RESTORATION FORM

Township 13S Range 45E Sec. 29,32 County BAKER
State OREGON Date 9-24-93 No. _____

Corner Designation

1/4 Cor. Sec 29,32

Condition Report Only


☐ Not Found
☐ Renewed
☐ Unrecorded
☐ Surveyed In
☒ Referenced Out

Previous Renewals

Monument(s) Found: (Condition and Source)

Rock mound with an "X" scribed in a stone in the center of the mound. Located on top of a cutbank to the West of the Baker County Richland-Huntington road.

MONUMENT DETAIL

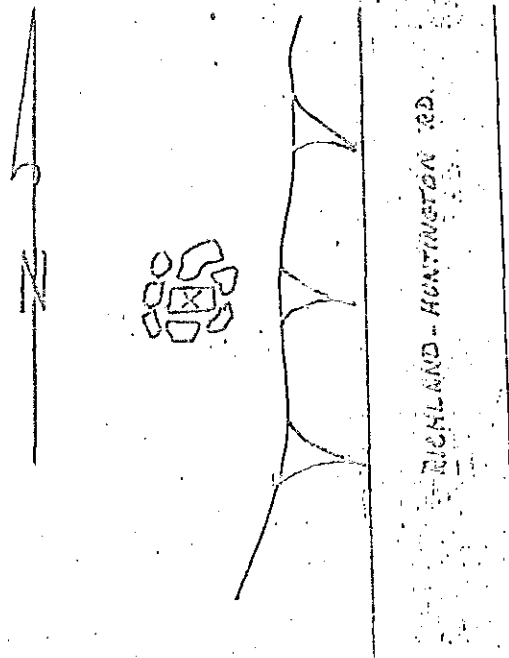

Accessories Found:

NONE

BAKER COUNTY SURVEYOR

Received _____

Recorded _____

Survey Inst. No. _____

File No. _____

FILED OCT 8, 1993

BAKER COUNTY SURVEYOR

SURVEY NO. 13-45-4