
## BASIS OF BEARING (1941.76') (N 86° 57' E - 2596.90') 1/4 CORNER **BRASS CAP**

Parcel Line Table			Record Data	
Line #	Length	Direction	Length	Direction
L51	151.90	\$25° 53' 11"E	152.00	S23° 34'E
L52	137.51	S10° 50′ 11″E	137.60	S08° 31'E
L53	195.67	S30° 38' 11"E	195.80	S28° 19'E
L54	136.41	S03° 55' 49"W	136.50	S06° .05'W
L55	71.95	N67° 33' 49"E	72.00	N69° 53'E
L56	65.26	S46° 27' 11"E	65.30	S44° 08'E
L57	225.25	S30° 46' 11"E	225.40	\$28° 27'E
L58	51.07	S19° 18' 49"W	51.10	S21° 38'W
L59	131.82	S42° 50' 11"E	131.90	S40° 31'E
L60	128.82	S14° 55' 49"W	128.90	S17° 15'W
L61	64.16	S28° 03' 49"W	64.20	S30° 23'W
L62	133.51	N88° 46′ 49 <b>"</b> E	133.60	S88° 54'E
L63	96.64	\$32° 51' 11"E	96.70	S30° 32'E
L64	290.71	S25° 21' 11"E	290.90	S23° 02'E
L65	233.95	S16° 58' 11"E	234.10	\$14° 39'E
L66	100.44	S30° 00' 11"E	100.50	S27° 41'E
L67	161.02	S06° 10' 29"E	161.00	S03° 50'E
L68	203.74	`S40° 11' 32"W	203.70	S42° 34'W
L69	150.43	S84° 46' 28"E	150.40	S82° 24'E
L70	112.44	S17° 41' 23"E	112.40	S15° 24'E
L71	55.56 <sup>-</sup>	S17° 39' 20"W	55.80	S20° 05'W

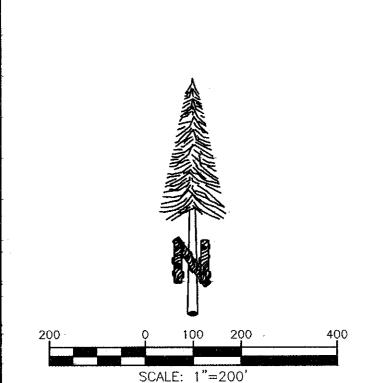

# RECORD OF SURVEY FOR IDAHO POWER COMPANY

A PORTION OF THE EAST 1/2 OF THE NORTHEAST 1/4 OF SECTION 5, TOWNSHIP 13 SOUTH, RANGE 45 EAST, WILLAMETTE MERIDIAN, BAKER COUNTY, OREGON -2011-

#### LEGEND

2 1 11 12	SECTION COR. MONUMENT AS NOTE
<sup>11</sup> \ <sub>36</sub>	1/4 COR. MONUMENT AS NOTED
•	SET 5/8" REBAR W/ CAP P.L.S. 70716
<b>•</b>	M.C. IDAHO POWER BRASS CAP
(656 <mark>.</mark> 38')	RECORD DATA
	BOUNDARY LINE
	LOT LINE
<del></del>	SECTION LINE

### RECORD DATA

SECTION CORNER COMPUTED POINT

-1957 JDAHO POWER 2085'

TRAVERSE LINE

IPCO 1957 SURVEY D-BR-54 IPCO 1957 SURVEY D-BR-102 IPCO 1957 SURVEY D-BR-68 R.O.S. 12-45-1 R.O.S. 12-45-4

#### BASIS OF BEARING:

That part of the North line of the Northeast 1/4 of Section 5, Township 13 South, Range 45 East, Willamette Meridian, being from the North 1/4 corner of Section 5 to the found Idaho Power Meander Corner, taken as North 84'34'34" East and distance between monuments found to be 1940.34 feet, based upon Oregon State plane North Zone.

#### NARRATIVE:

This survey was made at the request of Gil Green with Idaho Power Company to mark the angle points of the 1957 2085' Contour Traverse Line, as shown. The original traverse line was rotated and scaled to fit between the found Idaho Power Meander Corner Brass Cap monuments. Each tangent of the traverse line received a portion of the scale adjustment. The East 1/4 corner of Section 5 was reset using Single Proportion between the found Original Stone Section corner and the found Idaho Power Meander Corner Brass Cap, based on the measurements shown on the 1957 Idaho Power Survey drawing D-BR-102.

#### CERTIFICATE:

I, Russell Badgley, a Registered Professional Land Surveyor hereby state that on February 21, 2011 a survey was completed, of a portion of the East 1/2 of the Northeast 1/4 of Section 5, Township 13 South, Range 45 East, W.M., and was made by me or under my direction supervision. That the property corners are marked as shown and that this map is a true and accurate representation of said PROFESSIONAL LAND SURVEYOR survey.

RUSSELL BADGLEY

1/4 CORNER SET BRASS CAP ON 5/8" REBAR


SECTION CORNER

FOUND ORIGINAL STONE

CHECON

NOVEMBER 13, 2007 RUSSELL BADGLEY 70716 LS

COUNTY SURVEYOR RECORDING INFO Received Aug. 1, Zoll Accepted SURVEY NO. \_\_13-45-7\_ DRAWING NO. \_

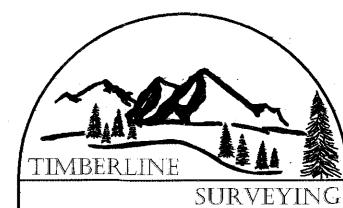

847 PARKCENTRE WAY, SUTTE 3, NAMPA, IDAHO 8365 P: 208-465-5687 ~ F: 208-465-5690

JOB NO: 011023 SHEET: 1 OF 1

NDEX NO. 13452-5

13-45-7