

GOVERNMENT CORNER RECORD

Township 13S Range 45E Section 5 S.E. COR. County BAKER

State OREGON Date 3/1/11 Number E-9

Corner Designation :S.E. COR SEC 5

Previous Renewals _____

Monument(s) Found: (Condition and Source)

FOUND ORIGINAL STONE WITH NOTCHES AS DESCRIBED

Accessories Found:

FOUND STONE PILE 3' WEST OF CORNER

Monument & Accessories Set (Procedure and Description)

REBUILT MOUND OF STONES 3'X3'X2' HIGH 3' WEST OF CORNER


☒ Condition Report Only
☐ Not Found
☐ Renewed
☐ Surveyed In
☐ Reference

MONUMENT DETAIL

☒ Found ☐ Set



Sketch of Monument, Accessories and General Area

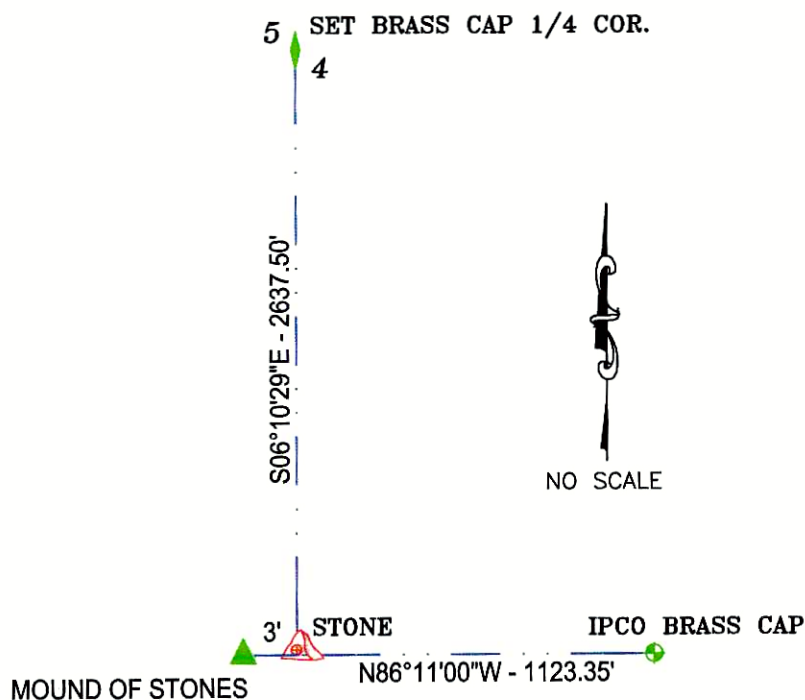

Surveyor's Seal

REGISTERED
PROFESSIONAL
LAND SURVEYOR

Russell Badgley
7/22/11

OREGON
NOVEMBER 13, 2007
RUSSELL BADGLEY
70716LS

RENEWAL DATE : 12-31-11

Agency TIMBERLINE
SURVEYING

Party Chief REB

Notekeeper ES

Witness(s) _____

COUNTY SURVEYOR RECORDING INFO

Received Aug 1, 2011

Filed _____

Survey No. 13-45-9

Drawing No. _____

Index No. _____