


LEGEND

△ FOUND GPS CONTROL POINT, 2" ALUMINUM CAP ON 5/8" IRON ROD SET IN COUNTY SURVEY 14-36-34

● SET 2 3/8" X 30" ALUMINUM PIPE WITH 3" ALUMINUM CAP AS DESCRIBED AND SET ALUMINUM POST WITH ATTACHED SIGNS NEARBY

ALL BEARINGS AND DISTANCES SHOWN HEREON ARE OREGON STATE PLANE, NORTH ZONE EXCEPTING BEARING TREE TIES, WHICH ARE TRUE BEARINGS AND DISTANCES MEASURED TO THE CENTER OF THE TREE.

THE TIE LINES SHOWN HEREON ARE FROM GPS CONTROL POINTS TO THE TRUE BOUNDARY ANGLE POINT POSITION, NOT TO THE ANGLE POINT WITNESS CORNERS.

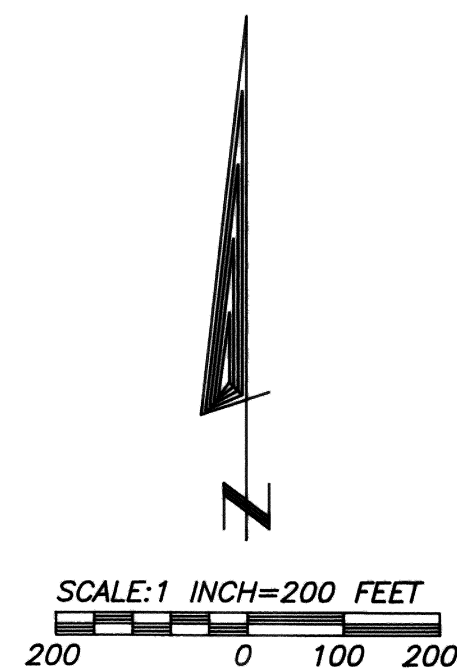

AP 1414

SET 2 3/8" X 30" ALUMINUM PIPE WITH 3" ALUMINUM CAP 27" IN THE GROUND WITH ROCK COLLAR BUILT AROUND PIPE, FROM WHICH:

A 9" LODGEPOLE PINE BEARS N 52° E, 14.3', SCRIBED "AP 1414 BT"
A 8" LODGEPOLE PINE BEARS N 39° W, 31.9', SCRIBED "AP 1414 BT"

AP 1425

SET 2 3/8" X 30" ALUMINUM PIPE WITH 3" ALUMINUM CAP 28" IN THE GROUND WITH ROCK COLLAR BUILT AROUND PIPE, FROM WHICH:

A 10" LODGEPOLE PINE BEARS S 72° E, 7.7', SCRIBED "AP 1425 BT"
A 11" LODGEPOLE PINE BEARS N 42° E, 29.7', SCRIBED "AP 1425 BT"

AP 1435

SET 2 3/8" X 30" ALUMINUM PIPE WITH 3" ALUMINUM CAP 25" IN THE GROUND WITH ROCK COLLAR BUILT AROUND PIPE, FROM WHICH:



A 9" LODGEPOLE PINE BEARS N 19° W, 14.7', SCRIBED "AP 1435 BT"
A 12" LODGEPOLE PINE BEARS N 56° E, 22.0', SCRIBED "AP 1435 BT"

AP 1443

SET 2 3/8" X 30" ALUMINUM PIPE WITH 3" ALUMINUM CAP 28" IN THE GROUND WITH ROCK COLLAR BUILT AROUND PIPE, FROM WHICH:

A 14" LODGEPOLE PINE BEARS N 33° E, 18.3', SCRIBED "AP 1443 BT"
A 11" LODGEPOLE PINE BEARS N 61° W, 48.8', SCRIBED "AP 1443 BT"

AP	BEARING	DISTANCE(FT.)
1414	N 35°46'19" W	85.49
	N 41°54'44" W	269.75
	N 23°13'16" W	215.01
	N 35°21'35" W	203.94
	N 24°07'41" W	246.34
TO	N 26°12'23" W	109.58
	N 36°03'12" W	160.82
	N 55°26'43" W	218.89
	N 51°42'33" W	200.88
	N 50°10'24" W	230.99
1425	N 49°50'47" W	216.07
	N 48°59'24" W	242.15
	N 47°05'56" W	212.77
	N 44°19'18" W	202.67
	N 43°31'24" W	154.52
TO	N 42°54'46" W	232.97
	N 41°18'06" W	200.16
	N 46°47'00" W	248.55
	N 64°50'35" E	249.06
	N 57°54'41" E	231.55
1435	N 74°10'43" E	192.60
	N 64°01'38" E	252.96
	N 55°07'35" E	123.05
	N 65°26'45" E	239.66
	N 74°02'00" E	314.99
TO	N 80°16'19" E	152.05
	S 82°43'52" E	216.68
	N 73°53'14" E	233.72

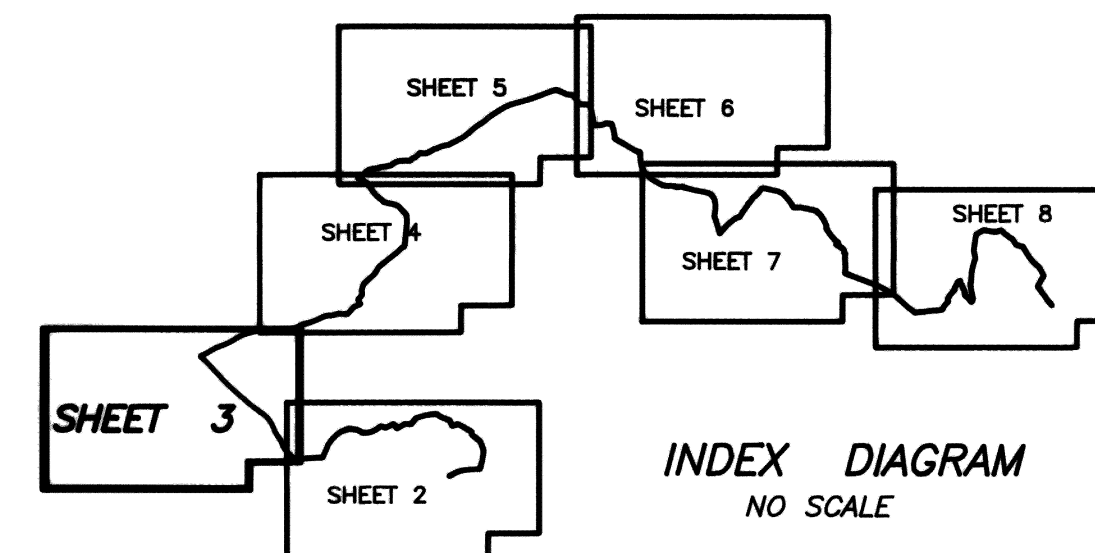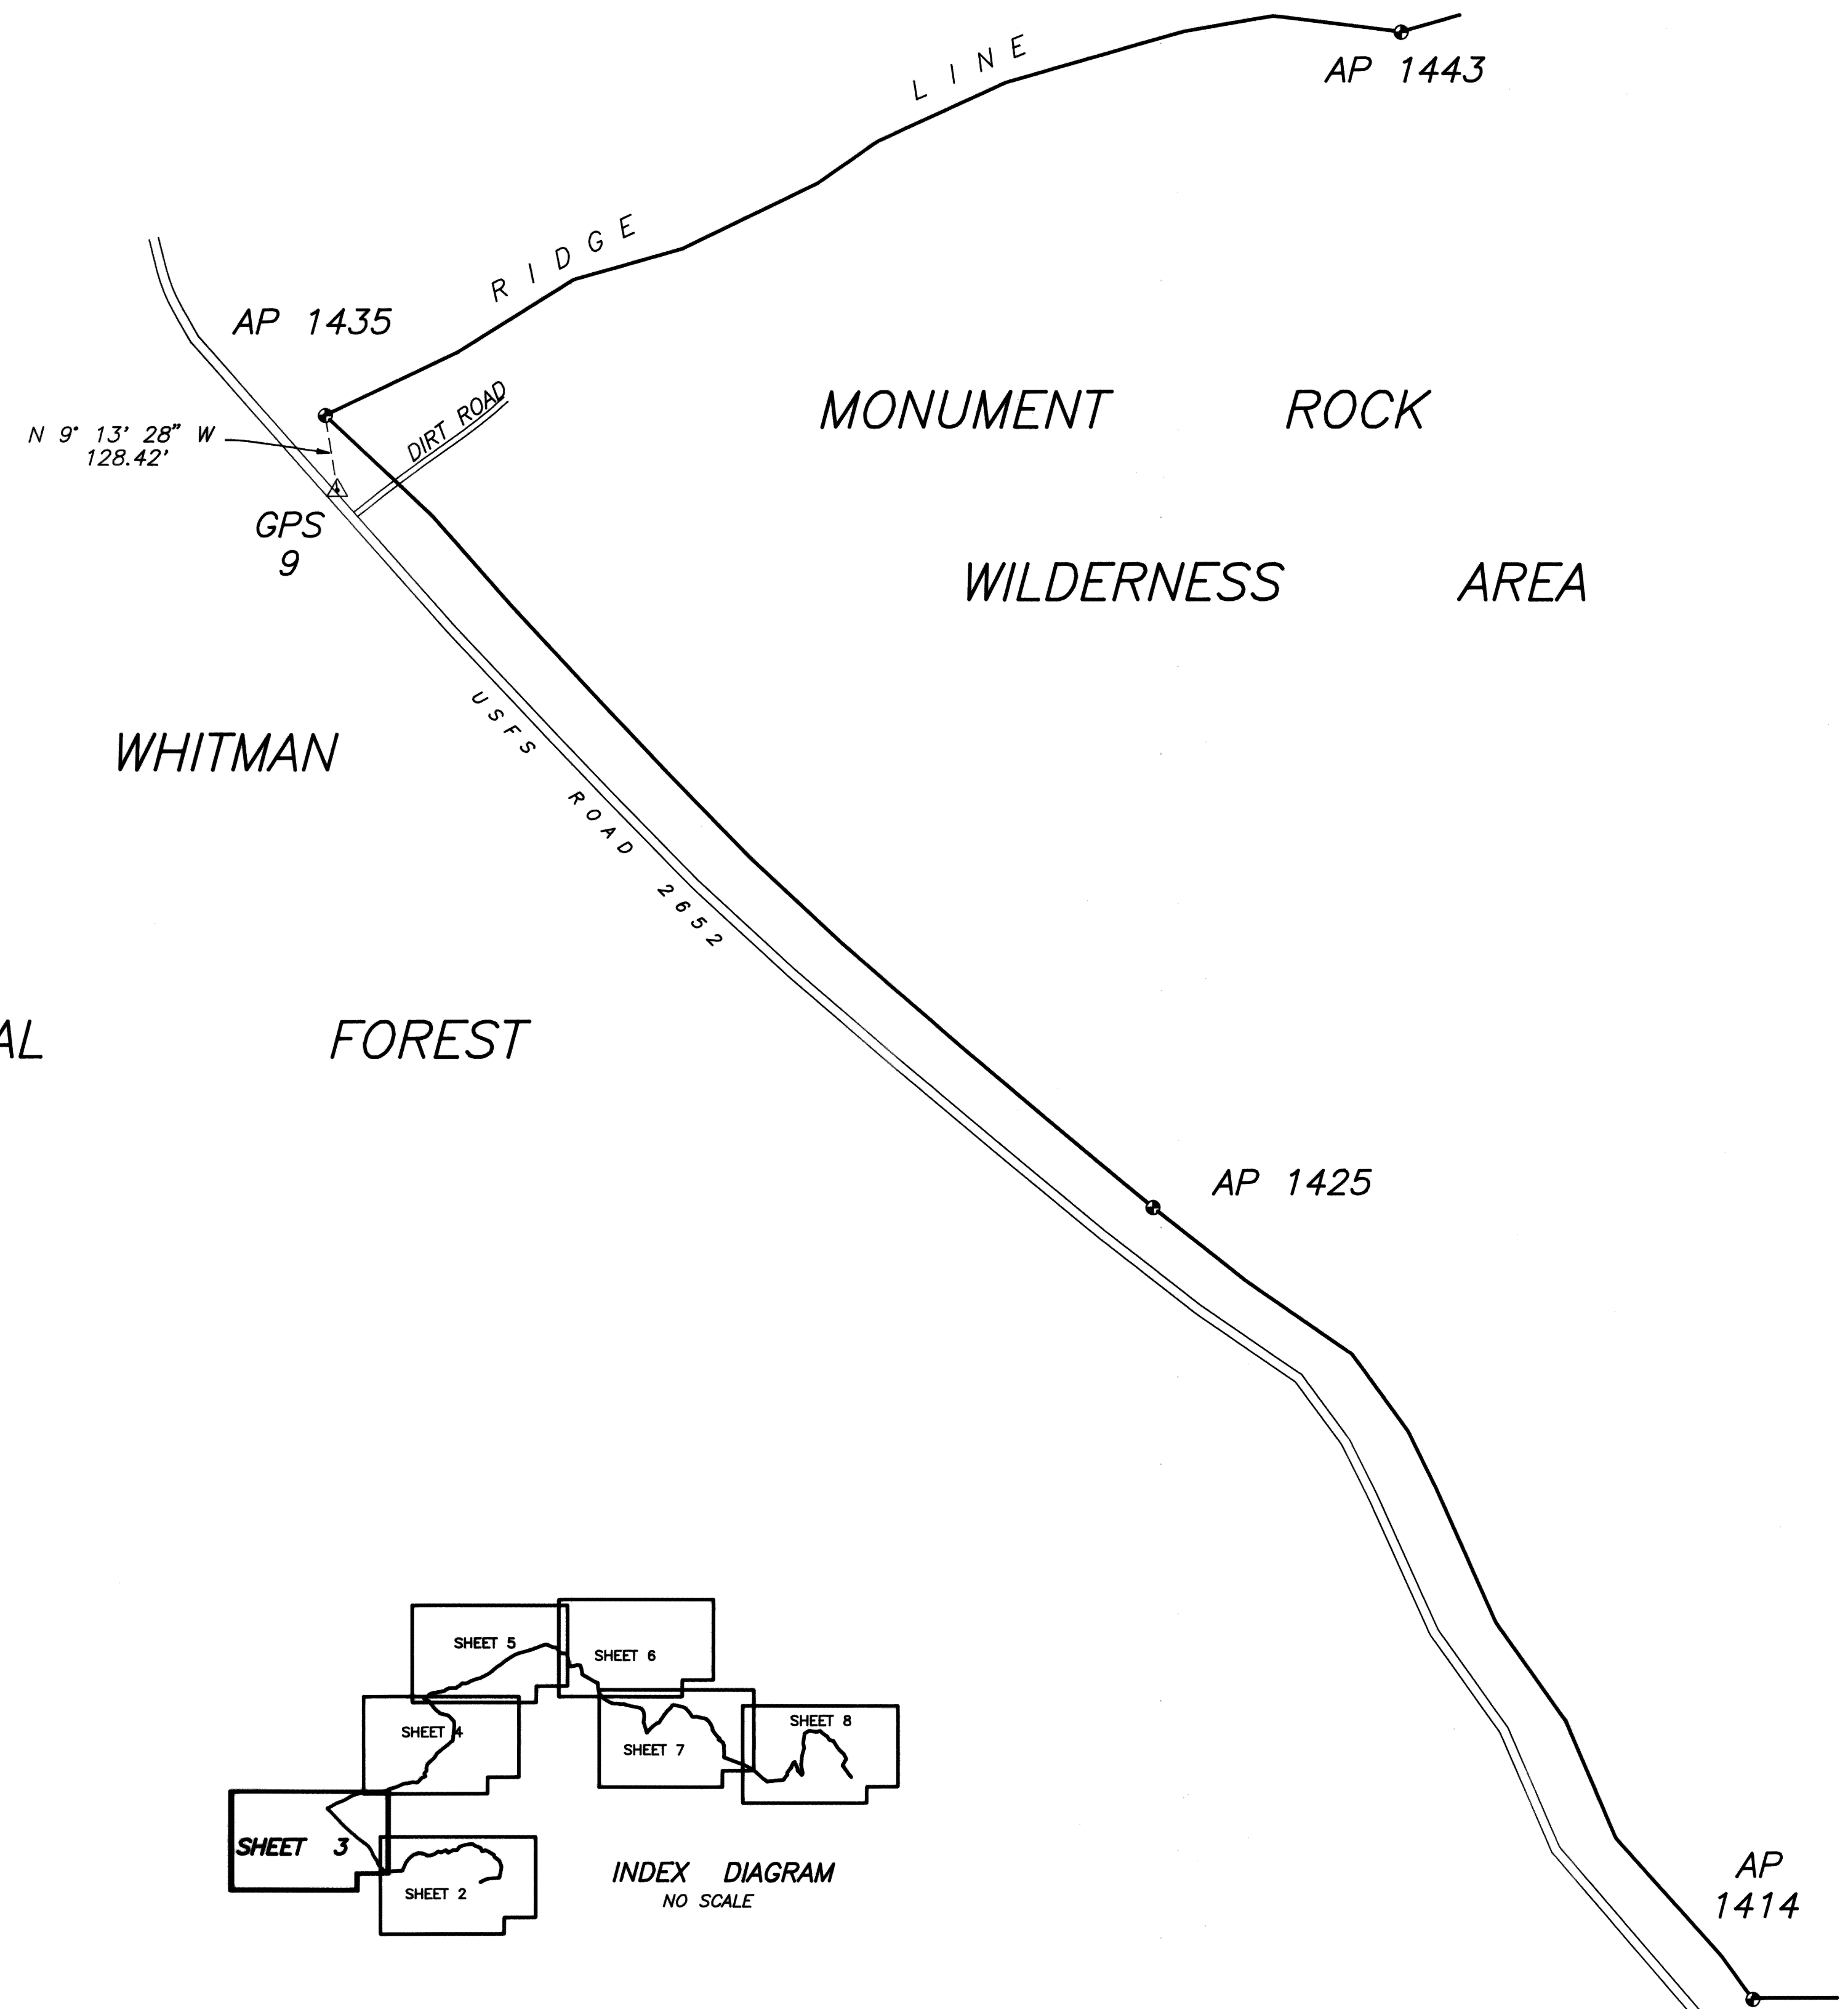

MONUMENT ROCK WILDERNESS BOUNDARY
CONTRACT NO. 53-04M3-5-0038

REGISTERED
PROFESSIONAL
LAND SURVEYOR

JULY 16, 1988
STEVEN E. WOODS
2365
EXPIRATION DATE: 6/30/98

SKINNER & ASSOCIATES, INC.		MAP OF	
LAND SURVEYING and U.S. MINERAL SURVEYS		RECORD OF SURVEY	
EXPLORATION SURVEY SERVICES		PREPARED FOR	
PROPERTY BOUNDARY SURVEYS		US FOREST SERVICE	
PATENT MINERAL SURVEYS		WALLOWA-WHITMAN N. F.	
P. O. BOX 321 321 HOLLY STREET JUNCTION CITY, OR (541) 998-2453		LOCATED IN	
DATE: 5/10/96		TWPS 14 S RANGES 35 1/2 & 36 E	
DRAWN BY: PA		WM, BAKER COUNTY, OREGON	
CHECKED BY: SEW		SHEET NO: 3 of 8	