


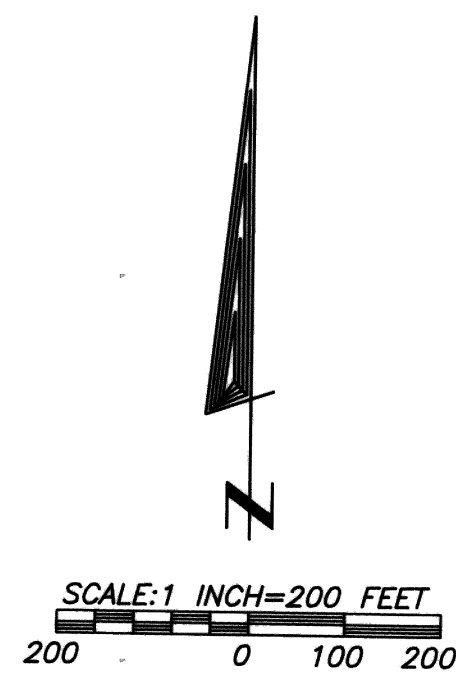

LEGEND

△ FOUND GPS CONTROL POINT, 2" ALUMINUM CAP ON 5/8" IRON ROD SET IN COUNTY SURVEY 14-36-34

● SET 2 3/8" X 30" ALUMINUM PIPE WITH 3" ALUMINUM CAP AS DESCRIBED AND SET ALUMINUM POST WITH ATTACHED SIGNS NEARBY

ALL BEARINGS AND DISTANCES SHOWN HEREON ARE OREGON STATE PLANE, NORTH ZONE EXCEPTING BEARING TREE TIES, WHICH ARE TRUE BEARINGS AND DISTANCES MEASURED TO THE CENTER OF THE TREE.

THE TIE LINES SHOWN HEREON ARE FROM GPS CONTROL POINTS TO THE TRUE BOUNDARY ANGLE POINT POSITION, NOT TO THE ANGLE POINT WITNESS CORNERS.

GPS 8
USFS ROAD
LOOKOUT CREEK
W. C. AP 1482
S 66°07'59" E 429.51'
AP 1478

MONUMENT ROCK

WALLOWA WHITMAN

NATIONAL FOREST

WILDERNESS

AREA

AP 1461

AP 1451

AP 1443

AP	BEARING	DISTANCE(FT.)
1443	N 73°53'14" E	233.72
	S 82°04'25" E	251.21
	N 76°34'27" E	232.89
	N 54°44'07" E	143.37
	N 75°37'23" E	278.04
	N 66°04'41" E	192.10
	N 65°19'26" E	205.61
	N 88°57'41" E	183.09
	N 69°46'56" E	164.07
	S 82°44'10" E	221.70
TO	N 46°05'25" E	99.32
	N 40°03'47" E	166.51
	N 69°01'30" E	149.28
	N 60°25'56" E	32.97
	N 28°29'30" W	129.59
	N 37°27'26" E	170.84
	N 02°00'44" W	138.39
	N 16°48'02" E	132.69
	N 46°35'07" E	209.05
	N 49°07'56" E	194.85
TO	N 30°10'59" E	198.47
	N 48°26'12" E	201.27
	N 52°42'07" E	225.73
	N 54°30'14" E	197.64
	N 42°07'36" E	135.10
	N 60°14'24" E	103.91
	N 10°22'22" E	135.15
	N 02°42'22" E	228.36
	N 10°00'22" E	167.78
	N 03°12'22" E	131.43
TO	N 02°39'38" W	164.05
	N 43°04'38" W	113.72
	N 44°34'38" W	176.17
	N 62°14'38" W	119.31
	N 73°47'38" W	109.99
	N 79°23'38" W	124.90
	N 74°28'38" W	89.48
	N 44°50'38" W	129.56
	N 51°43'38" W	112.78
	N 42°09'38" W	103.46
1478	N 31°28'38" W	140.75
	N 35°23'38" W	117.45
	N 43°40'20" W	55.93
TO	N 61°24'47" W	260.47

AP 1443

SET 2 3/8" X 30" ALUMINUM PIPE WITH 3" ALUMINUM CAP 28" IN THE GROUND WITH ROCK COLLAR BUILT AROUND PIPE, FROM WHICH:

A 14" LODGEPOLE PINE BEARS N 33° E, 18.3', SCRIBED "AP 1443 BT"
A 11" LODGEPOLE PINE BEARS N 61° W, 48.8', SCRIBED "AP 1443 BT"

AP 1451

SET 3 1/4" BRASS CAP EPOXIED INTO A DRILL HOLE IN THE TOP OF A ROCK OUTCROP AT THE NORTH END OF A ROCKY RIDGE, FROM WHICH:

RM 1- A DRILL HOLE AND CENTERED CHISELED "+" BEARS N 55° E, 12.50'
RM 2- A DRILL HOLE AND CENTERED CHISELED "+" BEARS S 39° E, 9.16'

AP 1461

SET 2 3/8" X 30" ALUMINUM PIPE WITH 3" ALUMINUM CAP 28" IN THE GROUND WITH ROCK COLLAR BUILT AROUND PIPE, FROM WHICH:

A 9" PONDEROSA PINE BEARS N 84° E, 37.2', SCRIBED "AP 1461 BT"
A 7" LODGEPOLE PINE BEARS S 2° W, 15.3', SCRIBED "AP 1461 BT"

AP 1478


SET 3 1/4" BRASS CAP EPOXIED INTO A DRILL HOLE ON THE TOP OF A FLAT SHALE SHELF AT THE NW END OF A PROMINENT SHALE OUTCROP, FROM WHICH:

RM 1- A DRILL HOLE AND CENTERED CHISELED "+" BEARS S 39° E, 5.10'
A 10" FIR BEARS S 38° W, 72.18', SCRIBED "AP 1478 BT"

AP 1482

SET 2 3/8" X 30" ALUMINUM PIPE WITH 3" ALUMINUM CAP 29" IN THE GROUND AS WITNESS CORNER WITH ROCK COLLAR BUILT AROUND PIPE, FROM WHICH TRUE POINT FOR AP 1482 BEARS N 57° 06' 45" W 26.38', AND ALSO:

A 6" LODGEPOLE PINE BEARS N 76° W, 3.8', SCRIBED "X BT"
A 8" LODGEPOLE PINE BEARS S 10° W, 5.7', SCRIBED "X BT"

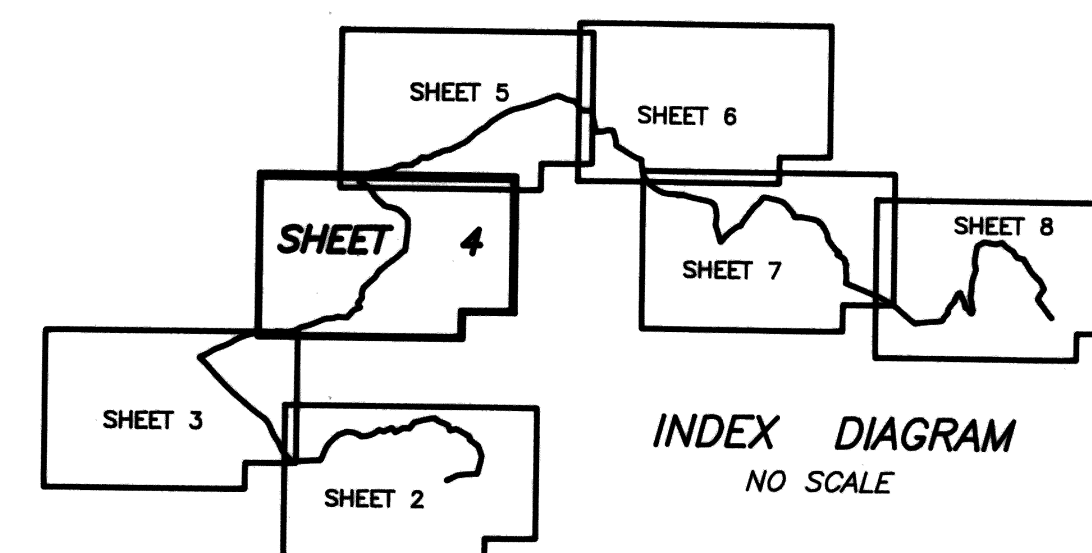

MONUMENT ROCK WILDERNESS BOUNDARY
CONTRACT NO. 53-04M3-5-0038

SKINNER & ASSOCIATES, INC.		MAP OF	
LAND SURVEYING and U.S. MINERAL SURVEYS		RECORD OF SURVEY	
EXPLORATION SURVEY SERVICES		PREPARED FOR	
PROPERTY BOUNDARY SURVEYS		US FOREST SERVICE	
PATENT MINERAL SURVEYS		WALLOWA-WHITMAN N. F.	
P. O. BOX 321 JUNCTION CITY, OR (541) 998-2453		LOCATED IN	
DATE: 5/10/96		TWPS 14 S RANGES 35 1/2 & 36 E WM, BAKER COUNTY, OREGON	
DRAWN BY: PA		CHECKED BY: SEW	
FILED: JULY 31, 1997		SHEET NO. 4 of 8	

FILED JULY 31, 1997
BAKER COUNTY SURVEYOR
SURVEY NO. 14-352-4