

(SEE SHEET 6 OF 8 FOR AP 1541)

WALLOWA WHITMAN NATIONAL FOREST

AP 1552

S 83° 19' 01" W
2786.24'

W.C.
AP 1583


GPS
16

S 57° 47' 06" W
641.07'

W.C.
AP 1591

W.C.
AP 1600


AP 1552

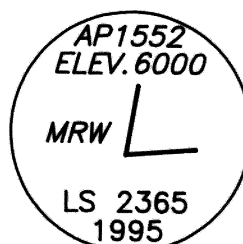

SET 3" BRASS CAP EPOXIED INTO DRILL HOLE IN BEDROCK ON STEEP NORTH FACING SLOPE, FROM WHICH:

A 21" FIR BEARS S 25° E, 5.3', SCRIBED "AP 1552 BT"
A 5" FIR BEARS N 58° E, 35.1', SCRIBED "X BT"


AP 1571

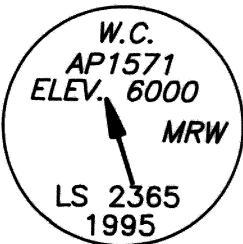

SET 2 3/8" X 30" ALUMINUM PIPE WITH 3" ALUMINUM CAP 28" IN THE GROUND AS WITNESS CORNER WITH ROCK MOUND BUILT AROUND PIPE, FROM WHICH TRUE POINT FOR AP 1571 BEARS N16° 19' 54" W 13.26', AND ALSO:

A 9" FIR BEARS N 52° E, 24.2', SCRIBED "X BT"
A 10" FIR BEARS N 56° W, 17.1', SCRIBED "X BT"


AP 1583

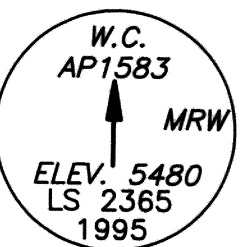

SET 2 3/8" X 30" ALUMINUM PIPE WITH 3" ALUMINUM CAP 27" IN THE GROUND AS WITNESS CORNER WITH ROCK COLLAR BUILT AROUND PIPE, FROM WHICH TRUE POINT FOR AP 1583 BEARS N 11° 40' 35" W 6.43', AND ALSO:

A 15" FIR BEARS S 45° W, 38.3', SCRIBED "X BT"
A 6" PONDEROSA PINE BEARS N 38° W, 26.5', SCRIBED "X BT"


AP 1591

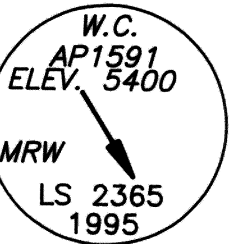

SET 2 3/8" X 30" ALUMINUM PIPE WITH 3" ALUMINUM CAP 28" IN THE GROUND AS WITNESS CORNER WITH ROCK COLLAR BUILT AROUND PIPE, FROM WHICH TRUE POINT FOR AP 1591 BEARS S 25° 47' 29" E 37.23', AND ALSO:

A 11" FIR BEARS S 67° W, 14.4', SCRIBED "X BT"
A 10" FIR BEARS N 16° W, 3.7', SCRIBED "X BT"


AP 1600

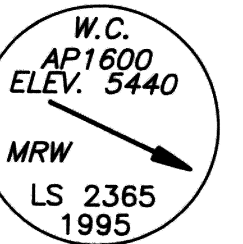

SET 2 3/8" X 30" ALUMINUM PIPE WITH 3" ALUMINUM CAP 28" IN THE GROUND AS WITNESS CORNER WITH ROCK COLLAR BUILT AROUND PIPE, FROM WHICH TRUE POINT FOR AP 1600 BEARS S 67° 48' 49" E 16.38', AND ALSO:

A 20" SPRUCE BEARS S 74° E, 12.6', SCRIBED "X BT"
A 6" FIR BEARS S 17° W, 8.4', SCRIBED "X BT"

AP 1613

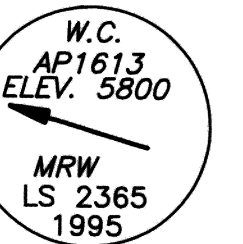

SET 2 3/8" X 30" ALUMINUM PIPE WITH 3" ALUMINUM CAP 28" IN THE GROUND AS WITNESS CORNER WITH ROCK MOUND BUILT AROUND PIPE, FROM WHICH TRUE POINT FOR AP 1613 BEARS N 69° 11' 25" W 8.00', AND ALSO:

A 9" FIR BEARS S 12° E, 29.4', SCRIBED "X BT"
A 10" FIR BEARS N 79° W, 30.8', SCRIBED "X BT"

AP 1617



SET 2 3/8" X 30" ALUMINUM PIPE WITH 3" ALUMINUM CAP 16" IN THE GROUND WITH ROCK MOUND BUILT AROUND PIPE, FROM WHICH:

A 14" FIR BEARS S 18° W, 28.5', SCRIBED "AP 1617 BT"
A 9" FIR BEARS S 61° E, 26.7', SCRIBED "AP 1617 BT"



MONUMENT ROCK WILDERNESS AREA

AP BEARING DISTANCE(FT.)

1541	S 00°37'22" E	125.01
	S 07°45'22" E	203.40
	S 22°44'22" E	152.80
	S 36°09'22" E	103.19
TO	S 44°44'22" E	182.56
	S 56°54'22" E	147.84
	S 62°42'22" E	197.44
	S 83°19'22" E	174.62
	S 89°05'22" E	105.17
	S 84°16'22" E	86.32
1552	S 02°46'18" E	21.83
1552	N 84°12'21" E	170.98
	S 71°03'45" E	135.89
	S 76°22'50" E	163.88
	S 77°09'08" E	149.55
	S 80°21'07" E	160.64
TO	S 70°33'56" E	157.97
	S 45°56'13" E	94.20
	S 18°39'14" E	110.31
	S 06°27'41" E	199.34
	S 09°18'15" W	209.62
	S 19°07'01" E	258.00
1571	S 14°24'21" E	218.03
1571	N 41°58'24" E	92.20
	N 29°09'22" E	47.99
	N 40°36'32" E	166.81
	N 51°10'51" E	197.02
	N 54°22'46" E	126.54
	N 87°42'19" E	67.91
TO	N 29°43'37" E	138.10
	N 34°55'12" E	154.39
	N 42°39'34" E	69.53
	N 22°57'08" E	64.84
	N 51°13'54" E	59.69
	N 32°03'44" E	135.80
	N 52°09'10" E	140.77
	N 39°33'48" E	101.70
1583	N 27°59'18" E	89.43

AP BEARING DISTANCE(FT.)

1583	N 84°13'09" E	92.96
	S 79°32'51" E	209.45
	S 71°42'51" E	162.41
TO	S 64°40'51" E	129.92
	S 46°30'51" E	80.64
	S 39°11'51" E	137.76
	S 38°40'51" E	112.00
1591	S 24°14'56" E	122.08
1591	S 85°59'02" E	108.72
	N 88°33'58" E	132.27
	S 72°24'02" E	95.13
TO	S 84°59'02" E	88.79
	S 71°51'02" E	68.85
	S 76°08'02" E	88.79
	S 63°36'02" E	61.61
	S 32°58'02" E	51.64
1600	S 68°40'42" E	41.67
1600	S 35°47'42" E	192.95
	S 22°11'43" E	172.35
	S 01°54'02" W	55.92
	S 20°44'05" E	81.50
	S 37°42'56" E	241.75
	S 42°21'30" E	94.56
	S 60°25'46" E	78.11
TO	S 50°54'57" W	75.34
	S 59°38'01" E	190.62
	S 40°58'44" E	75.57
	S 04°02'15" E	76.99
	S 62°12'17" E	30.48
	S 04°30'47" W	141.27
	S 05°42'58" E	206.05
	S 04°02'26" W	86.21
1613	S 12°41'43" W	68.39
1613	S 69°10'16" E	244.60
TO	S 67°55'16" E	384.83
	S 70°05'16" E	304.39
1617	S 61°42'16" E	371.79

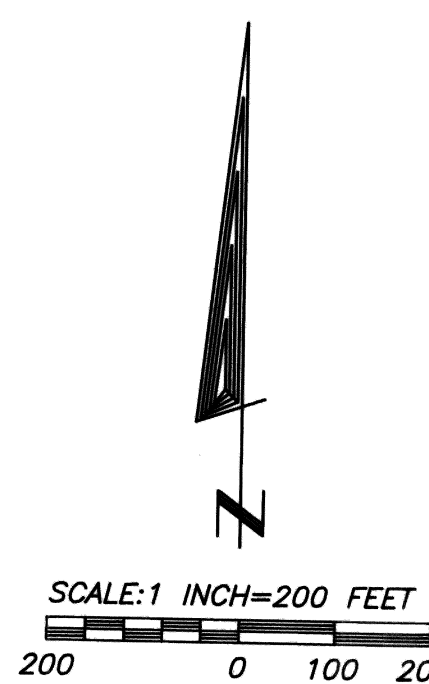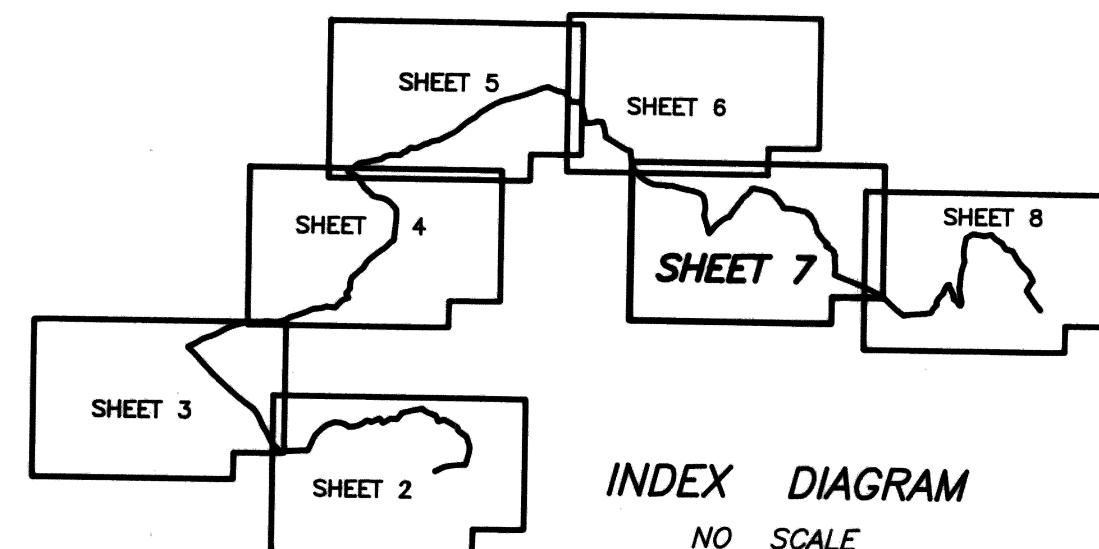

LEGEND

△ FOUND GPS CONTROL POINT, 2" ALUMINUM CAP ON 5/8" IRON ROD SET IN COUNTY SURVEY 14-36-34

● SET 2 3/8" X 30" ALUMINUM PIPE WITH 3" ALUMINUM CAP AS DESCRIBED AND SET ALUMINUM POST WITH ATTACHED SIGNS NEARBY


ALL BEARINGS AND DISTANCES SHOWN HEREON ARE OREGON STATE PLANE, NORTH ZONE EXCEPTING BEARING TREE TIES, WHICH ARE TRUE BEARINGS AND DISTANCES MEASURED TO THE CENTER OF THE TREE

THE TIE LINES SHOWN HEREON ARE FROM GPS CONTROL POINTS TO THE TRUE BOUNDARY ANGLE POINT POSITION, NOT TO THE ANGLE POINT WITNESS CORNERS.

W.C.
AP 1613

AP
1617

MONUMENT ROCK WILDERNESS BOUNDARY
CONTRACT NO. 53-04M3-5-0038

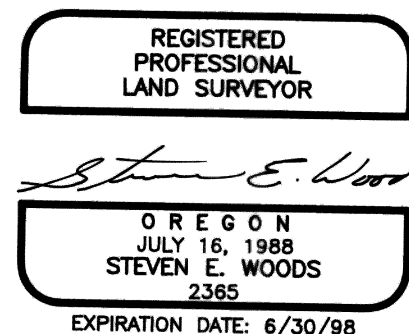

SKINNER & ASSOCIATES, INC	MAP OF
LAND SURVEYING and U.S. MINERAL SURVEYS	RECORD OF SURVEY
EXPLORATION SURVEY SERVICES	PREPARED FOR
PROPERTY BOUNDARY SURVEYS	US FOREST SERVICE
PATENT MINERAL SURVEYS	WALLOWA-WHITMAN N. F.
DATE: 5/10/96	LOCATED IN
DRAWN BY: PA	TWPS 14 S RANGES 35 1/2 & 36 E
CHECKED BY: SEW	WM, BAKER COUNTY, OREGON
SHEET NO: 7 of 8	