



AP 1617

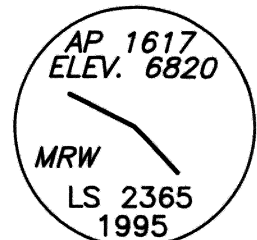

SET 2 3/8" X 30" ALUMINUM PIPE WITH 3" ALUMINUM CAP 16" IN THE GROUND WITH ROCK MOUND BUILT AROUND PIPE, FROM WHICH:

A 14" FIR BEARS S 18° W, 28.5', SCRIBED "AP 1617 BT"
A 9" FIR BEARS S 61° E, 26.7', SCRIBED "AP 1617 BT"


AP 1621

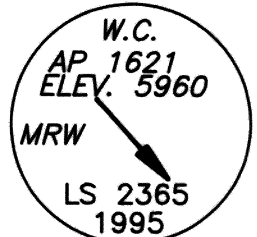

SET 2 3/8" X 30" ALUMINUM PIPE WITH 3" ALUMINUM CAP 26" IN THE GROUND AS WITNESS CORNER WITH ROCK MOUND BUILT AROUND PIPE, FROM WHICH TRUE POINT FOR AP 1621 BEARS S 2° 46' 08" E 10.40', AND ALSO:

A 12" TAMARACK BEARS N 41° E, 35.8', SCRIBED "X BT"
A 20" SPRUCE BEARS S 7° E, 14.2', SCRIBED "X BT"

AP 1630

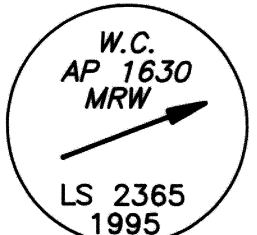

SET 2 3/8" X 30" ALUMINUM PIPE WITH 3" ALUMINUM CAP 22" IN THE GROUND AS WITNESS CORNER WITH ROCK COLLAR BUILT AROUND PIPE, FROM WHICH TRUE POINT FOR AP 1630 BEARS N 72° 28' 45" E 5.55', AND ALSO:


A 22" SPRUCE BEARS S 34° W, 16.7', SCRIBED "X BT"
A 9" SPRUCE BEARS N 42° W, 6.7', SCRIBED "X BT"

GPS 2

AP BEARING DISTANCE(FT.)

1617	S 54°24'48" E	152.71
TO	S 47°07'48" E	237.66
	S 48°47'48" E	169.88
1621	S 49°45'49" E	258.44
1621	N 69°09'35" E	93.32
	N 89°55'21" E	129.70
	N 79°13'00" E	154.21
	N 85°54'59" E	97.16
	S 89°53'40" E	124.34
	N 76°22'16" E	127.72
TO	N 24°06'47" E	123.80
	N 45°23'09" E	131.50
	N 02°53'08" W	84.20
	N 28°14'39" E	118.33
	N 43°08'52" E	175.05
	N 08°59'28" W	36.12
	N 34°51'21" E	53.90
	N 24°10'32" E	133.72
1630	N 70°13'36" E	71.99
1630	S 12°18'36" W	55.02
	S 38°48'47" E	92.43
	S 14°56'34" E	79.93
TO	S 31°36'28" E	80.08
	S 03°55'21" E	112.20
	S 56°37'57" E	124.48
	S 19°13'08" E	57.17
	S 45°21'10" E	55.24
1635	S 47°58'32" E	23.91


AP 1652

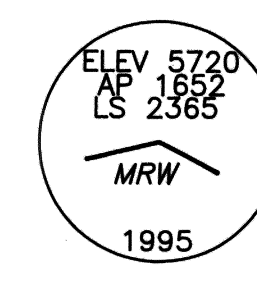

SET 2 3/8" X 30" ALUMINUM PIPE WITH 3" ALUMINUM CAP 22" IN THE GROUND WITH ROCK COLLAR BUILT AROUND PIPE, FROM WHICH:

A 8" FIR BEARS N 42° W, 14.6', SCRIBED "AP 1652 BT"
A 6" FIR BEARS S 31° W, 4.1', SCRIBED "AP 1652 BT"


AP 1659

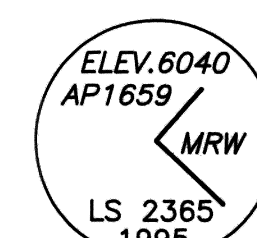

SET 2 3/8" X 30" ALUMINUM PIPE WITH 3" ALUMINUM CAP 25" IN THE GROUND WITH ROCK MOUND BUILT AROUND PIPE, FROM WHICH:

A 10" FIR BEARS N 12° E, 26.3', SCRIBED "AP 1659 BT"
A 6" LODGEPOLE PINE BEARS S 60° E, 7.4', SCRIBED "AP 1659 BT"

AP 1664

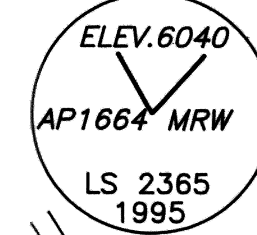


SET 2 3/8" X 30" ALUMINUM PIPE WITH 3" ALUMINUM CAP 28" IN THE GROUND WITH ROCK COLLAR BUILT AROUND PIPE, FROM WHICH:

A 14" FIR BEARS S 42° E, 10.7', SCRIBED "AP 1664 BT"
A 23" TAMARACK BEARS S 68° W, 31.2', SCRIBED "AP 1664 BT"

AP BEARING DISTANCE(FT.)

1635	N 21°34'45" E	90.48
	N 10°30'30" W	153.55
	N 10°05'33" W	168.99
TO	N 11°04'58" W	85.23
	N 23°22'36" E	47.17
	N 02°48'49" E	178.79
	N 03°52'55" E	142.25
	N 16°37'35" E	189.17
1641	N 17°39'04" E	134.33
1641	N 11°22'00" W	198.00
TO	N 06°49'00" E	253.00
	N 11°26'00" E	171.00
1645	N 59°08'37" E	135.10
1645	N 61°09'41" E	90.33
	S 81°55'00" E	110.44
TO	S 75°43'40" E	177.17
	N 77°35'00" E	118.01
1652	N 67°53'30" E	63.23
1652	S 44°30'03" E	171.95
	S 56°19'00" E	210.34
	S 31°33'28" E	163.82
	S 73°40'11" E	192.29
TO	S 30°45'37" E	267.75
	S 36°31'42" E	184.17
	S 48°20'46" E	240.58
	S 28°08'07" E	246.79
	S 33°16'19" W	227.49
1659	S 26°17'58" W	92.62
1659	S 36°05'06" E	223.91
	S 39°04'36" E	113.09
TO	S 31°51'21" E	145.62
	S 47°37'27" E	80.38
1664	S 33°57'01" E	63.58

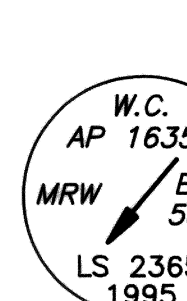


AP 1635

SET 2 3/8" X 30" ALUMINUM PIPE WITH 3" ALUMINUM CAP 24" IN THE GROUND AS WITNESS CORNER WITH ROCK COLLAR BUILT AROUND PIPE, FROM WHICH TRUE POINT FOR AP 1635 BEARS S 9°15' 21" E 12.78', AND ALSO:

A 13" SPRUCE BEARS N 53° E, 10.3', SCRIBED "X BT"
A 10" SPRUCE BEARS N 64° W, 19.3', SCRIBED "X BT"


AP 1641

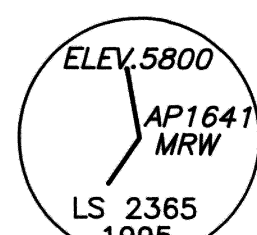

SET 2 3/8" X 30" ALUMINUM PIPE WITH 3" ALUMINUM CAP 18" IN THE GROUND WITH ROCK MOUND BUILT AROUND PIPE, FROM WHICH:


A 11" FIR BEARS N 63° E, 8.1', SCRIBED "AP 1641 BT"
A 12" FIR BEARS N 64° W, 10.6', SCRIBED "AP 1641 BT"

AP 1645

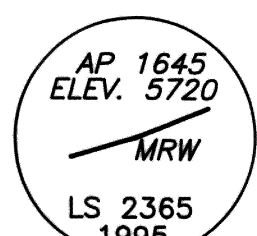


SET 2 3/8" X 30" ALUMINUM PIPE WITH 3" ALUMINUM CAP 24" IN THE GROUND WITH ROCK MOUND BUILT AROUND PIPE, FROM WHICH:

A 11" FIR BEARS S 12° E, 21.5', SCRIBED "AP 1645 BT"
A 10" FIR BEARS N 88° W, 16.7', SCRIBED "AP 1645 BT"

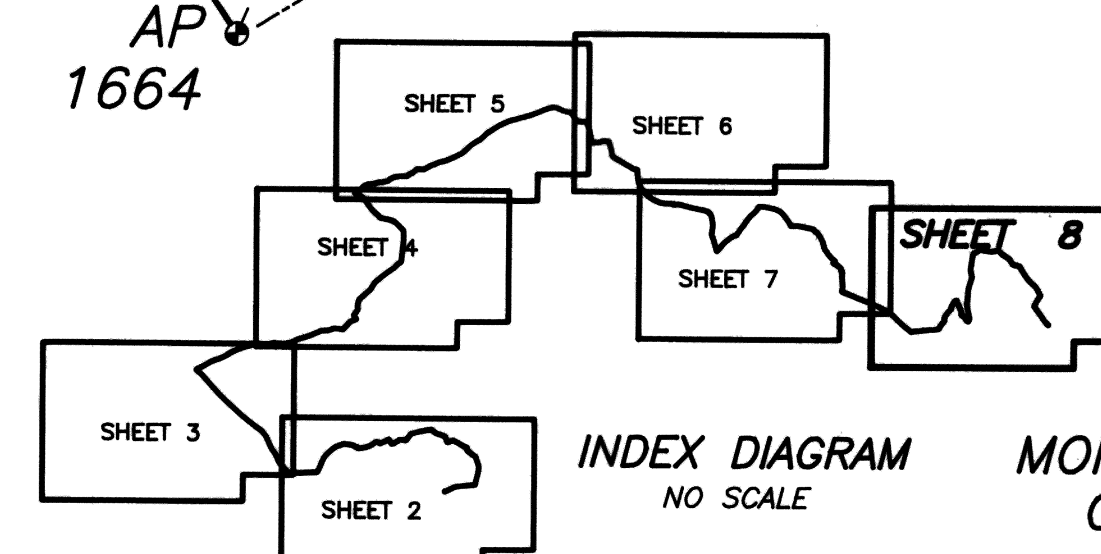

MONUMENT ROCK WILDERNESS BOUNDARY CONTRACT NO. 53-04M3-5-0038

SKINNER & ASSOCIATES, INC.		MAP OF	
LAND SURVEYING and U.S. MINERAL SURVEYS		RECORD OF SURVEY	
EXPLORATION SURVEY SERVICES		PREPARED FOR	
PROPERTY BOUNDARY SURVEYS		US FOREST SERVICE	
PATENT MINERAL SURVEYS		WALLOWA-WHITMAN N. F.	
P. O. BOX 321 JUNCTION CITY, OR (541) 998-2453		LOCATED IN	
JULY 16, 1988 STEVEN E. WOODS 2365		TOWNSHIP 14 S RANGES 35 1/2 & 36 E WM, BAKER COUNTY, OREGON	
DATE: 5/10/96	DRAWN BY: FA	CHECKED BY: SEW	SHEET NO: 8 of 8

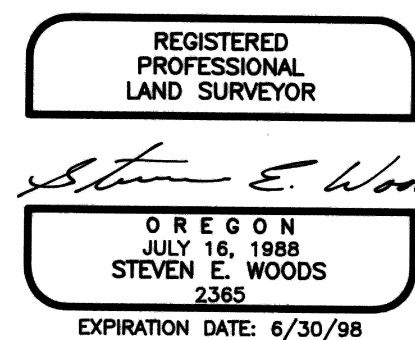

LEGEND

△ FOUND GPS CONTROL POINT, 2" ALUMINUM CAP ON 5/8" IRON ROD SET IN COUNTY SURVEY 14-36-34

● SET 2 3/8" X 30" ALUMINUM PIPE WITH 3" ALUMINUM CAP AS DESCRIBED AND SET ALUMINUM POST WITH ATTACHED SIGNS NEARBY

--- EXISTING FENCE

ALL BEARINGS AND DISTANCES SHOWN HEREON ARE OREGON STATE PLANE, NORTH ZONE EXCEPTING BEARING TREES TIES, WHICH ARE TRUE BEARINGS AND DISTANCES MEASURED TO THE CENTER OF THE TREE
THE TIE LINES SHOWN HEREON ARE FROM GPS CONTROL POINTS TO THE TRUE BOUNDARY ANGLE POINT POSITION, NOT TO THE ANGLE POINT WITNESS CORNERS.

SCALE: 1 INCH=200 FEET
200 0 100 200

