

CERTIFIED RECORD OF LAND CORNER MONUMENTATION

History of original corner establishment:

A resurvey of Auxillary Meridian GLO 1901 by George R. Campbell


Set a basalt stone 15" x 12" x 9", 10' in ground marked with 4 notches on the south, and 2 notches on the north side.

From which:

A 12" Black Pine bears S86°W, 40 lks (26.40 ft.)

A 20" Tamarack bears N34°W, 17 lks (11.22 ft.)

In 1972, the U.S. Forest Service found a down Western Larch snag, B.T., marked T14S R35½E.BT. Also found a B.T. cruise tag marked RGK 8/6/69

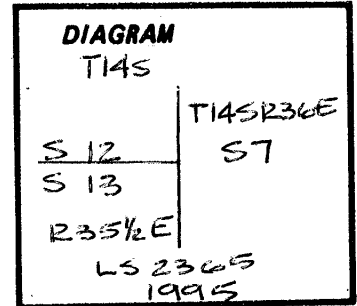

Description of corner evidence found:

Found stone 16" x 10" x 8", 3" above ground, marked with 4 notches on the south edge and 2 notches on the north face. No other markings visible.

From Which:

A rooted stump and remnants of a burnt snag down with burnt out blaze N30°W, 10.0 feet to center.

Nothing remains of other bearing tree of record

Description of monument and accessories | established to perpetuate the original location of this corner:

Set in place of stone a 2 3/8" x 30" aluminum pipe with 3" aluminum cap. Pipe is set 21" into the ground. Set corner stone next to pipe and painted it with red paint. Corner falls in a burnt clear cut 78 ft. east of a creek, 82 ft. south of creek, and 160 ft. north of old ditch. Painted all found evidence.

New Bearing Trees:

A 7" Fir bears S9°W, 132.9 ft. to aluminum nail at side center. Scribed "T14SR35½ES13BT". A 3/4" brass washer stamped PLS 2457 is nailed flush at bottom of blaze.

A 12" Larch Bears N78°W, 121.3 ft. to aluminum nail at side center, scribed "T14SR35½ES12BT". A 3/4" brass washer stamped PLS2457 is nailed at bottom of blaze.

REGISTERED
PROFESSIONAL
LAND SURVEYOR

Steven E. Woods

OREGON
JULY 26, 1988
STEVEN E. WOODS
2365

RENEWAL DATE: 6/30/98

Office of..... County of.....

State of....., I hereby certify that the within instrument was filed in this office
for record on the..... day of....., 19.....

..... by
(COUNTY OFFICIAL) (DEPUTY)

Form R6-7100-57 (9/71)

FILED AUG. 19, 1997
BAKER COUNTY SURVEYOR
SURVEY NO. 14-35½-9

*GPO-591-971, 1988