

CERTIFIED RECORD OF LAND CORNER MONUMENTATION

V-17


History of original corner establishment:

Corner established by Henry W. Cooke under GLO contract no 512 dated Aug 23, 1884.

Surveyor General records state:

Set basalt stone 14x10x10 ins 10 ins in ground for cor to secs 26, 27, 34 & 35 marked with 1 notch on S and 2 notches on E edges from which;

A fir 10 ins diam bears N 75° E, 7 lks dist marked T14SR36ES26BT
A fir 10 ins diam bears S 35° E, 13 lks dist marked T14SR36ES35BT
A fir 12 ins diam bears S 25° W, 32 lks dist marked T14SR36ES34BT
A fir 30 ins diam bears N 50° W, 61 lks dist marked T14SR36ES27BT

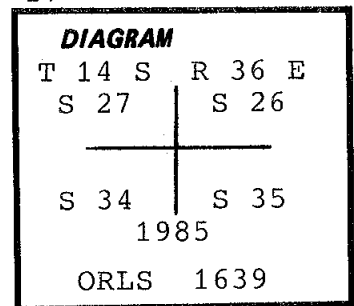

Description of corner evidence found:

A stone 15x8x7 ins in place with 4 ins projecting out of the ground and marked with 1 notch on S and 2 notches on E edges in small rock mound.
A fir log 10 ins diam bears N 75° E, 7 lks dist with full record scribes on open face.
A fir 24 ins diam bears S 35° E, 13 lks dist with fully healed blaze.
A rotten log bears S 25° W, 32 lks dist..no scribes identified.
No trace of other bearing tree.

NOTE: Each original accessory bearing tree has signs 54-3 and 54-4 attached below a 6-inch band of red paint around and placed by others.

Description of monument and accessories I established to perpetuate the original location of this corner:

At position of original stone...

Set 2½ inch aluminum cap on a 2 inch aluminum pipe 30 ins long and buried 25 ins in the ground with 5 ins projecting out of the ground with a surrounding rock mound and a 6-foot steel fence post alongside with a sign 54-9 attached. Buried original stone alongside.

Aluminum cap marked as shown in corner diagram.

New bearing trees established;

A tamarach 9 ins diam bears N 16° E, 14.7 ft dist marked T14SR36ES26BT
A alpine fir 8 ins diam bears S 71° W, 10.1 ft dist marked T14SR36ES34BT
A alpine fir 8 ins diam bears N 22° W, 6.7 ft dist marked T14SR36ES27BT

Each new bearing tree has a brass washer marked PLS 1639 nailed flush with BT blaze and has signs 54-3 and 54-9 attached below a 6-inch band of red paint.

I hereby certify that the above described corner monument was properly established by me and witnessed by Jim DeMastus on Nov. 13, 1985.

Witnessed: Jim DeMastus

REGISTERED
PROFESSIONAL
LAND SURVEYOR

William L. Hanley

OREGON
JULY 14, 1978
WILLIAM L. HANLEY
1639

Office of.....Surveyor.....County of.....Baker.....
State of.....Oregon....., I hereby certify that the within instrument was filed in this office
for record on the.....day of....., 19.....
.....by.....
(COUNTY OFFICIAL) (DEPUTY)