

CERTIFIED RECORD OF LAND CORNER MONUMENTATION

Z-23


History of original corner establishment:

Corner established by Eugene P. McCornack under GLO contract no. 398 dated July 2, 1881.

Surveyor general records state:

Set basalt stone 30x12x5 ins 22 ins in the ground for 1/4 sec cor marked 1/4 on W face from which:

A pine 20 ins diam bears N 70° W, 24 lks dist marked 1/4SBT
A pine 40 ins diam bears S 50° E, 38 lks dist marked 1/4SBT

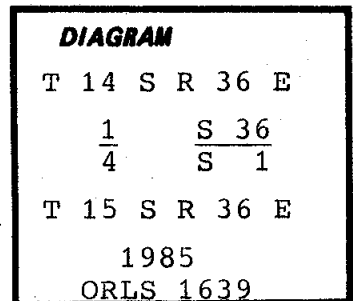

Description of corner evidence found:

A pine 48 ins diam with fragmentary scribes visible on partially healed and burned blaze for section 1 BT
No trace of section 36 BT which has apparently been destroyed by logging road construction.
No trace of original corner stone.

Corner position reestablished at record position from remaining original accessory.

Description of monument and accessories | established to perpetuate the original location of this corner:



Set a 2½ inch aluminum cap on a 2 inch aluminum pipe 30 inches long, 25 inches in the ground with 5 inches projecting out of the ground with a surrounding rock mound and a 6 foot steel fence post alongside with a sign 54-9 attached.

Aluminum cap marked as shown in corner diagram.

New bearing tree established: A pine 14 ins diam bears N 30½° W, 31.0 ft dist marked 1/4S36BT.

This new bearing tree has a brass washer marked PLS 1639 nailed flush with BT blaze and has signs 54-3 and 54-9 attached below a 6 inch band of red paint around. To the original bearing tree, attached signs 54-3 and 54-9 below a 6 inch band of red paint.

I hereby certify that the above described corner monument was properly established by me and witnessed by Jim DeMastus and Daryl Schuchardt on July 03, 1985.

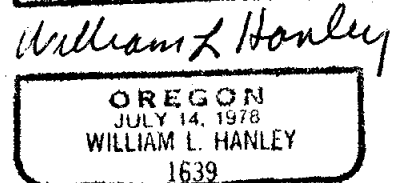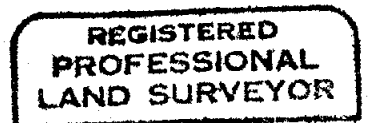

Office of.....Surveyor..... County of.....Baker.....
State of.....Oregon....., I hereby certify that the within instrument was filed in this office
for record on the..... day of....., 19.....
..... by
(COUNTY OFFICIAL) (DEPUTY)