


CERTIFIED RECORD OF LAND CORNER MONUMENTATION

Z-25

History of original corner establishment:

Corner established by Eugene P. McCornack under GLO contract no. 398 dated July 2, 1881.

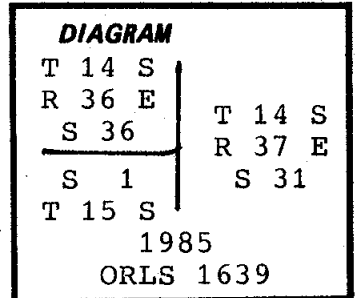

Surveyor general records state:

Set post 4½ ft long 4 ins square 24 ins in the ground for cor to Tps 14 and 15 S, R's 36 and 37 East, marked T14SS31 on NE, R37ES6 on SE, T15SS1 on SW and R36ES36 on NW faces with 6 notches on each edge from which:

A fir 12 ins diam bears N 55° E, 33 lks dist marked T14SR37ES31BT

A fir 9 ins diam bears S 70° E 39 lks dist marked T15SR37ES6BT

A tamarack 9 ins diam bears S 30° W, 20 lks dist marked T15SR36ES1BT

A fir 48 ins diam bears N 30° W, 10 lks dist marked T14SR36ES36BT

NOTE: Henry W. Cooke, under GLO contract no. 512 dated August 23, 1884, found inaccuracies in McCornack's work and revised this corner to pertain to Tps 14 & 15 S, R 36 E only.

Description of corner evidence found:

A tamarack 14 ins diam with 4 ins overgrowth on partially healed blaze with scribes "5SR36E" visible for section 1 BT.

A fir snag in extremely rotted condition for section 6 BT (No scribes on partially healed blaze...they were probably removed by Henry Cooke during his resurvey)

No trace of other two bearing trees.

At position established from the above recovered original accessory evidence found a 3 inch diam 12 inch long pointed post beginning 6 inches below ground surface.

At position of old post which is at record position from original BT's set monument as described below.

Description of monument and accessories | established to perpetuate the original location of this corner:


Set a 2½ inch aluminum cap on a 2 inch aluminum pipe 30 inches long, 25 inches in the ground with 5 inches projecting out of the ground with a surrounding rock mound and a 6 foot steel fence post alongside with a sign 54-9 attached. Buried original post alongside.

Aluminum cap marked as shown in corner diagram.

New bearing tree established: A pine 13 ins diam bears N 19° W, 25.3 ft dist marked T14SR36ES36BT

This new bearing tree has a brass washer marked PLS 1639 nailed flush with BT blaze and has signs 54-3 and 54-9 attached below a 6 inch band of red paint around. To the original bearing tree, attached signs 54-3 and 54-9 below a 6 inch band of red paint.

I hereby certify that the above described corner monument was properly established by me and witnessed by Jim DeMastus and Daryl Schuchardt on July 03, 1985.

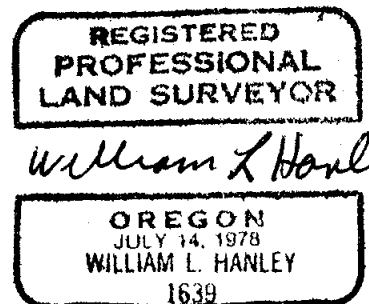

Office of.....Surveyor.....County of.....Baker.....
State of...Oregon....., I hereby certify that the within instrument was filed in this office
for record on the..... day of....., 19.....
..... by
(COUNTY OFFICIAL) (DEPUTY)

FILED 9-6-85
BAKER COUNTY SURVEYOR
SURVEY NO. 14-36-6