

CERTIFIED RECORD OF LAND CORNER MONUMENTATION

X-21


History of original corner establishment:

Corner established by Henry W. Cooke under GLO contract no. 512 dated Aug. 23, 1884.

Surveyor General records state:

Set a basalt stone 12x10x10 ins 15 ins in the ground for 1/4 sec cor marked 1/4 on W face from which:

A fir 10 ins diam bears N 10° E 155 lks dist marked 1/4SBT
A fir 12 ins diam bears N 15° W, 175 lks dist marked 1/4SBT

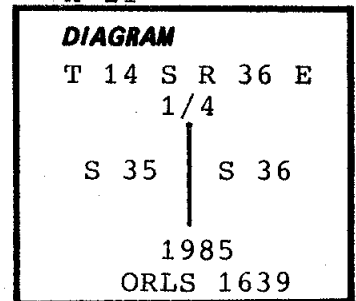

Description of corner evidence found:

A fir 20 ins diam with fragmentary scribes on previously opened blaze inside 5 ins overgrowth. This tree is in poor condition with visible rotten and decaying wood for section 35 BT.
No trace of section 36 BT

Original corner stone not found and presumed destroyed or covered by logging road construction.

Corner remonumented at record position as determined from remaining original bearing tree.

Description of monument and accessories established to perpetuate the original location of this corner:

Set a 2½ inch aluminum cap on a 2 inch aluminum pipe 30 inches long, 25 inches in the ground with 5 inches projecting out of the ground with a surrounding rock mound and a 6 foot steel fence post alongside with a sign 54-9 attached.


Aluminum cap marked as shown in corner diagram.

New bearing trees:

A fir 7 ins diam bears N 80° W, 46.6 ft dist marked 1/4S35BT
A fir 12 ins diam bears N 40° E, 46.8 ft dist marked 1/4S36BT

Each new bearing tree has a brass washer marked PLS 1639 nailed flush with BT blaze and has signs 54-3 and 54-9 attached below a 6 inch band of red paint around. To the original bearing tree, attached signs 54-3 and 54-9 below a 6 inch band of red paint.

I hereby certify that the above described corner monument was properly established by me and witnessed by Jim DeMastus and Daryl Schuchardt on July 09, 1985.

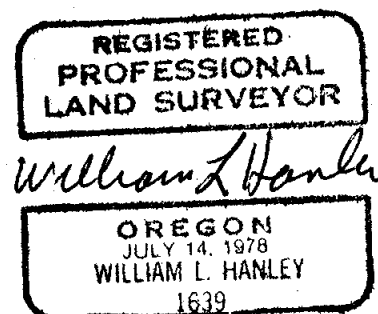

Office of.....Surveyor..... County of.....Baker.....
State of.....Oregon....., I hereby certify that the within instrument was filed in this office
for record on the..... day of....., 19.....
..... by
(COUNTY OFFICIAL) (DEPUTY)