

CERTIFIED RECORD OF LAND CORNER MONUMENTATION

X-25

History of original corner establishment:

Corner established by Eugene P. McCornack under GLO contract no. 398 dated July 2, 1881.

Surveyor general records state:

Set basalt stone 24x10x8 ins 18 ins in the ground for 1/4 sec cor marked 1/4 on W face from which:

A mahogany 14 ins diam bears West, 25 lks dist marked 1/4SBT
A pine 16 ins diam bears S 85° E, 37 lks dist marked 1/4SBT

NOTE: Henry W. Cooke, under GLO contract no 512, dated August 23, 1884, revised this corner to pertain to section 36 only due to inaccuracies found in McCornack's work.

Description of corner evidence found:

A three-stemmed mahogany with scribes "1/4S" visible on open blaze and fragmentary scribe marks on lower blaze which is partially healed for section 36 BT.
A pine snag broken at 8 ft for section 31 bearing tree...no scribes visible and presumed removed by Henry Cooke during the course of his resurvey
A stone 21x10x8 ins marked 1/4 in mound of 10 stones.

Accessories found to be at record position from original stone and corner remonumented at that point.

Description of monument and accessories I established to perpetuate the original location of this corner:



Set a 2½ inch aluminum cap on a 2 inch aluminum pipe 30 inches long, 25 inches in the ground with 5 inches projecting out of the ground with a surrounding rock mound and a 6 foot steel fence post alongside with a sign 54-9 attached. Buried original stone alongside.

Aluminum cap marked as shown in corner diagram.

New bearing tree established: A pine 14 ins diam bears S 48° W, 34.5 ft dist marked 1/4S36BT.

This new bearing tree has a brass washer marked PLS 1639 nailed flush with BT blaze and has signs 54-3 and 54-9 attached below a 6 inch band of red paint around. To the original bearing trees, attached signs 54-3 and 54-9 below a 6 inch band of red paint.

I hereby certify that the above described corner monument was properly established by me and witnessed by Jim DeMastus and Daryl Schuchardt on July 03, 1985.

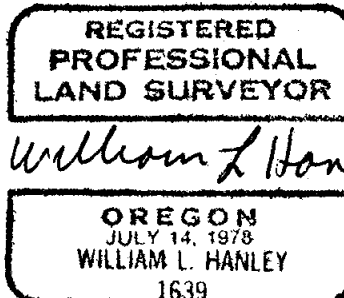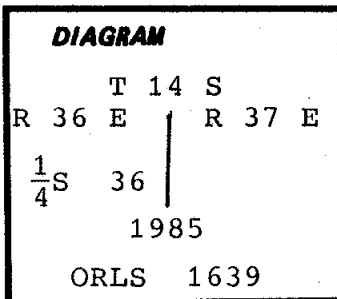

Office of.....Surveyor..... County of.....Baker.....
State of.....Oregon....., I hereby certify that the within instrument was filed in this office
for record on the..... day of....., 19.....
..... by
(COUNTY OFFICIAL) (DEPUTY)