


# CERTIFIED RECORD OF LAND CORNER MONUMENTATION

V-23

**History of original corner establishment:**

Corner established by Henry W. Cooke under GLO contract no. 512 dated Aug. 23, 1884.

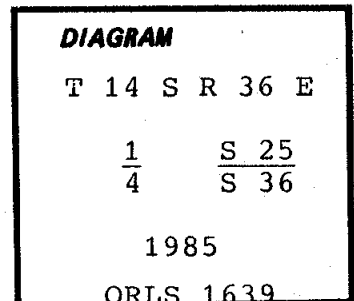

**Surveyor General records state:**

Set a granite stone 12x10x10 ins 8 ins in the ground for 1/4 sec cor marked 1/4 on N face from which:

A fir 6 ins dia bears N 35° E, 36 lks dist marked 1/4SBT  
 A pine 45 ins dia bears S 65° E, 16 lks dist marked 1/4SBT

**Description of corner evidence found:**

A pine 45 ins diam with scribes "4SBT" visible on open and pitched over blaze for section 36 original BT.

No trace of section 25 original bearing tree.

A granite stone 14x10x6 ins lying loose and downhill of reestablished corner position with 1/4 chisled on smooth face.

NOTE: Blaze and scribes are not oriented properly with record bearing recorded in official GLO record and loder tags dated 9-25-61 and 9-10-64 indicate record bearing and distance to be "N 26° W, 7½ ft". It appears that there is a transposition error in the duplicate or triplicate sets of the official record. Corner position reestablished in accordance with the official record....N 65° W, 16 lks (10.7 ft).

**Description of monument and accessories | established to perpetuate the original location of this corner:**


Set a 2½ inch aluminum cap on a 2 inch aluminum pipe 30 inches long, 25 inches in the ground with 5 inches projecting out of the ground with a surrounding rock mound and a 6 foot steel fence post alongside with a sign 54-9 attached. Buried stone alongside.

Aluminum cap marked as shown in corner diagram.

New bearing tree established: A fir 6 ins diam bears N 02½° W, 35.4 ft dist marked 1/4S25BT.

new bearing tree has a brass washer marked PLS 1639 nailed flush with BT blaze and has signs 54-3 and 54-9 attached below a 6 inch band of red paint around. To the original bearing tree, attached signs 54-3 and 54-9 below a 6 inch band of red paint.

I hereby certify that the above described corner monument was properly established by me and witnessed by Jim DeMastus and Daryl Schuchardt on July 09, 1985.

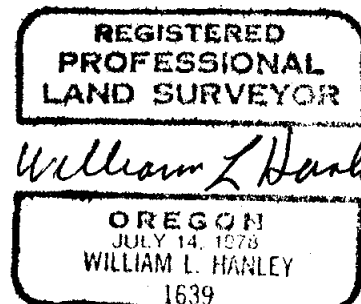

Office of.....Surveyor..... County of.....Baker.....  
 State of.....Oregon....., I hereby certify that the within instrument was filed in this office  
 for record on the..... day of....., 19.....  
 ..... by .....  
 (COUNTY OFFICIAL) (DEPUTY)