


CERTIFIED RECORD OF LAND CORNER MONUMENTATION

V-25

History of original corner establishment:

Corner established by Eugene P. McCornack under GLO contract no. 398 dated July 2, 1881.

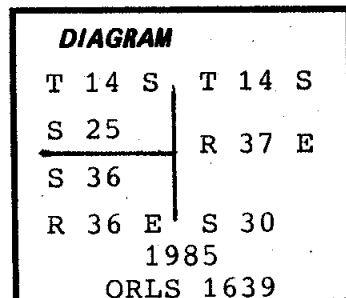

Surveyor general records state:

Set post 4 ft long 4 ins square 24 ins in the ground for cor to secs 25, 30, 31 & 36 marked T14SS30 on NE, R37ES31 on SE, R36ES36 on SW and S25 on NW faces with 5 notches on N and 1 notch on S edges from which:

A fir 16 ins diam bears N 85° E, 27 lks dist marked T14SR37ES30BT

A fir 12 ins diam bears S 25° E, 77 lks dist marked T14SR37ES31BT

A pine 8 ins diam bears S 15° W, 72 lks dist marked T14SR36ES36BT

A pine 8 ins diam bears N 60° W, 14 lks dist marked T14SR36ES25BT

NOTE: Henry W. Cooke, under GLO contract no 512 dated Aug. 23, 1884, revised this corner to pertain to sections 25 and 36 only due to inaccuracies found in McCornacks' work.

Description of corner evidence found:

A pine 22 ins diam with 6 ins overgrowth on partially healed blaze with scribed letter "S" visible for section 36 BT

A pine 20 ins diam with fully healed blaze for section 25 BT.

A sawed stump 22 ins diam with 5 ins overgrowth on stump remaining healed blaze and scribed letter "T" visible after removing overgrowth for section 30 BT.

No trace of section 31 BT or original post.

Corner remonumented using record bearing and distance from recovered original accessories.


Description of monument and accessories | established to perpetuate the original location of this corner:

Set a 2½ inch aluminum cap on a 2 inch aluminum pipe 30 inches long, 25 inches in the ground with 5 inches projecting out of the ground with a surrounding rock mound and a 6 foot steel fence post alongside with a sign 54-9 attached.

Aluminum cap marked as shown in corner diagram.

No new bearing trees established and signs 54-3 and 54-9 attached to original bearing trees and stump below a 6-inch band of red paint.

I hereby certify that the above described corner monument was properly established by me and witnessed by Jim DeMastus and Daryl Schuchardt on July 03, 1985.

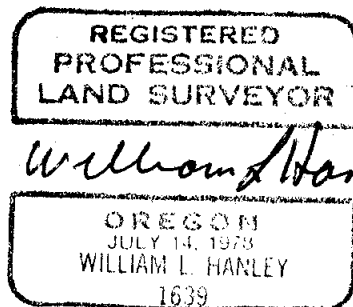

Office of.....Surveyor..... County of.....Baker.....
State of.....Oregon....., I hereby certify that the within instrument was filed in this office
for record on the..... day of....., 19.....
..... by
(COUNTY OFFICIAL) (DEPUTY)

Form R6-7100-57 (9/71)

☆U.S. GOVERNMENT PRINTING OFFICE-1983-793-276

FILED 9-6-85
BAKER COUNTY SURVEYOR
SURVEY NO. 14-36-11