

CERTIFIED RECORD OF LAND CORNER MONUMENTATION

E-17


History of original corner establishment:

Corner established by Henry W. Cooke under GLO contract no 427 dated December 15, 1881.

Surveyor General records state:

Set a basalt stone 15 x 10 x 10 ins, 10 ins in ground for cor to secs 2, 3, 10 & 11 marked with 5 notches on S and 1 notch on E edges from which:

- A pine 20 ins dia bears N40°E 32 lks dist marked T14SR36ES2 BT.
- A fir 18 ins dia bears S10°E, 200 lks dist marked T14SR36ES11 BT.
- A fir 8 ins dia bears S10°W, 145 lks dist marked T14SR36ES10 BT.
- A pine 30 ins dia bears N25°W. 171 lks dist marked T14SR36ES3 BT.

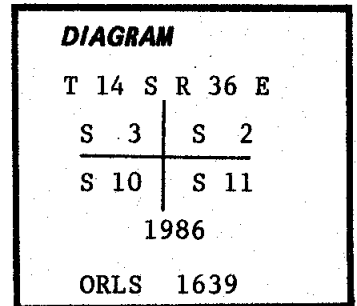

Description of corner evidence found:

No trace of original marked stone.

- A green pine 28 ins dia bears N40°E, 32 lks with scribes "4S 36E2 B" on proviously opened blaze.
- A green pine 20 ins dia bears S10°W, 145 lks with healed blaze (this tree called fir in original notes).
- A green fir 30 ins dia bears S10°E, 200 lks with fragmentary bark scribes on healed blaze.

Description of monument and accessories | established to perpetuate the original location of this corner:

At position determined by reversed record bearing and distance from original BT's...

Set a 2½" aluminum cap on a 2" aluminum pipe 30" long 25" in the ground with 5" projecting out of the ground with a surrounding rock mound and a 6' fence post alongside with sign 54-9 attached. Cap marked as shown in corner diagram.


Each original BT has signs 54-3 and 54-4 attached below a 6 inch band of red paint.

New bearing tree established:

A juniper 7 ins dia bears N74°W, 7.5 ft dist marked T14SR36ES3 BT.

New bearing tree has a brass washer marked PLS 1639 nailed flush with BT blaze and signs 54-3 and 54-9 attached below a 6 inch band of red paint.

I hereby certify that the above described corner monument was properly established by me on May 7, 1986.

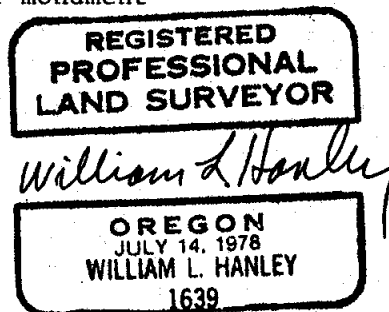

Office of.....County Surveyor..... County of.....Baker.....
State of.....Oregon....., I hereby certify that the within instrument was filed in this office
for record on the..... day of....., 19.....

..... by
(COUNTY OFFICIAL) (DEPUTY)

FILED May 15, 1986
BAKER COUNTY SURVEYOR
SURVEY NO. 14-36-13