

CERTIFIED RECORD OF LAND CORNER MONUMENTATION

E-25


History of original corner establishment:

Corner established by Eugene P. McCornack under GLO contract no. 398 dated July 2, 1881.

Surveyor General records state:

Set basalt stone 16 x 12 x 7 ins, 11 ins in the ground for cor to secs 1, 6, 7 & 12 marked with 1 notch on N and 5 notches on S edges and raised a mound of stone alongside. This corner is on steep and rocky N hillside. Pits impractical.

NOTE: Henry W. Cooke, under GLO contract no 512 dated Aug. 23, 1884, revised this corner to pertain to secs 1 & 12 only due to inaccuracies found in McCornacks' work.

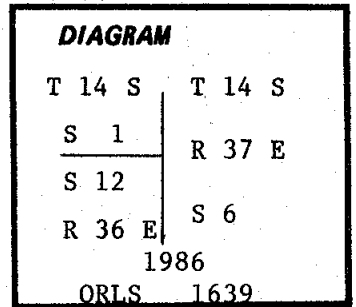

Description of corner evidence found:

A balalt stone 16 x 12 x 7 with fragmentary chislework in a mound of stone... JRM location tags and attention signs on two trees nearby.

None established during original survey.

Description of monument and accessories l established to perpetuate the original location of this corner:

At position of found stone...

Set a 2½" aluminum cap on 2" aluminum pipe 30" long, 12" in the ground to refusal with 18" projecting out of the ground and a surrounding rock mound with a 6' steel fence post alongside with a sign 54-9 attached. Cap marked as shown. Buried marked stone alongside.

New bearing trees established:

A mahogany 6 ins dia bears S85°W, 38.0 ft dist marked T14SR36ES12 BT.

A fir 7 ins dia bears N46°W, 35.9 ft dist marked T14SR36ES1 BT.

Each new bearing tree has a brass washer marked PLS 1639 nailed flush with BT blaze and has signs 54-3 and 54-9 attached below a surrounding band of red paint.

I hereby certify that the above corner monument was properly maintained to U.S.F.S. standards under my supervision and witnessed by Jim DeMastus on June 26, 1986.

**REGISTERED
PROFESSIONAL
LAND SURVEYOR**

William L Hanley

**OREGON
JULY 14, 1978
WILLIAM L. HANLEY
1639**

Office of.....County..Surveyor..... County of.....Baker.....

State of.....Oregon....., I hereby certify that the within instrument was filed in this office for record on the..... day of....., 19.....

..... by
(COUNTY OFFICIAL) (DEPUTY)