

CERTIFIED RECORD OF LAND CORNER MONUMENTATION

P-25

History of original corner establishment:


Corner established by Eugene P. McCornack under GLO contract no. 398 dated July 2, 1881.

Surveyor General records state:

Set basalt stone 20 x 6 x 5 ins, 10 ins in the ground for 1/4 sec cor marked 1/4 on W face from which:

A juniper 36 ins dia bears S70°E, 23 lks dist marked 1/4S BT.

A juniper 30 ins dia bears S45°W, 54 lks dist marked 1/4S BT.

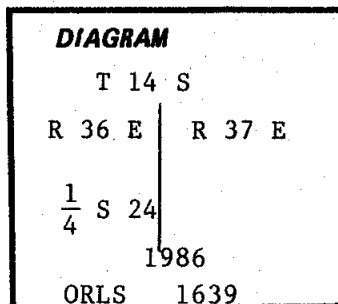

NOTE: Henry W. Cooke, under GLO contract no. 512 dated Aug. 23, 1884, revised this corner to pertain to section 24 only due to inaccuracies found in McCornacks' work.

Description of corner evidence found:

A basalt stone 16 x 8 x 3 ins lying in middle of rock mound marked 1/4.

(NOTE: True corner position determined to bear South, 1.5 ft dist as determined by distance intersection from recovered bearing trees.)

A juniper 34 ins dia bears S28°W (record states S45°W), 54 lks marked 1/4S BT on partially healed blaze.

A juniper 40 ins dia bears S49°E (record states S70°E), 23 lks marked 1/4S BT on partially healed blaze.

Description of monument and accessories established to perpetuate the original location of this corner:

At position determined by distance intersection from recovered original BT's... Set 2½" aluminum cap on 2" aluminum pipe 30" long 25" in ground with 5" proj, out of ground with a 6' steel fence post alongside with sign 54-9 attached. Cap marked as shown. Buried original stone in bottom of surrounding rock mound.

The original bearing trees have signs 54-3 and 54-9 attached below a surrounding band of red paint and has red paint on the face of BT blaze.

I hereby certify that the above corner monument was properly maintained to U.S.F.S. standards under my supervision and witnessed by Jim DeMastus on June 26, 1986.

**REGISTERED
PROFESSIONAL
LAND SURVEYOR**

William L. Hanley

**OREGON
JULY 14, 1978
WILLIAM L. HANLEY
1639**

Office of.....County Surveyor..... County of.....Baker.....
State of.....Oregon....., I hereby certify that the within instrument was filed in this office
for record on the..... day of....., 19.....

..... by
(COUNTY OFFICIAL) (DEPUTY)

FILED 7-7-86
BAKER COUNTY SURVEYOR
SURVEY NO. 14-36-21