

# CERTIFIED RECORD OF LAND CORNER MONUMENTATION

## DIAGRAM

T 14 S R 36 E

S35

S2

T 15 S

LS 2632

2004

### *History of original corner establishment:*

The original corner was established by Deputy Surveyor Eugene P. McCornack under GLO Contract #398 dated July 2, 1881 and approved March 25, 1882.

40.00 Set basalt stone 34X12X6 inches 25 inches in the ground for ¼ Sec Cor marked ¼ on W face from which: A fir 12 inch diam bears N5°W 45 lks. dist marked ¼ S BT.  
A fir 24 inch diam bears S40°W 47 lks. dist marked ¼ S BT.

### *Description of corner evidence found:*

A stone 32X11X7 inches with ¼ on the up face top to south firmly in the ground.

NW BT:

A 14" fir snag with scar but a burned off face at record.

SW BT:

No trace found.

### *Description of monument and accessories I establish to perpetuate the original location of this corner:*

Set a 3 ¼" aluminum cap on a 2 ½" X 30" aluminum pipe flush to the ground with the original stone buried alongside and south of the pipe. Cap marked as shown in the corner diagram.

From which: A 5/8" X 30" iron pin with orange cap stamped Carl J Stout, PLS 2632 brs N44°W dist 12.17'.


A 5/8" X 30" iron pin with orange cap stamped Carl J Stout, PLS 2632 brs N47°E dist 13.17'.

A 5/8" X 30" iron pin with orange cap stamped Carl J Stout, PLS 2632 brs S44°E dist 15.58'.

A 5/8" X 30" iron pin with orange cap stamped Carl J Stout, PLS 2632 brs S53°W dist 10.28'.

No live trees within limits. Compass 19° East declination and steel chain used to establish accessories.

Date 9/4/04

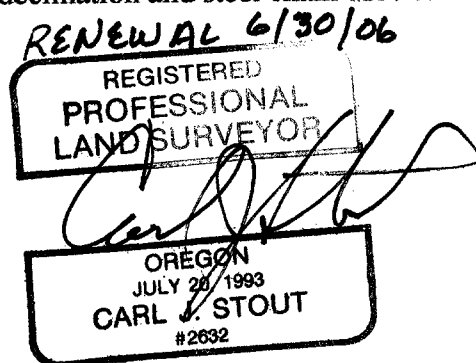

Office of County Surveyor, County of Baker, State of Oregon,  
I hereby certify that the within instrument was filed in this office  
for record on the \_\_\_\_\_ day of \_\_\_\_\_, 20\_\_\_\_.

\_\_\_\_\_  
(COUNTY OFFICIAL) by \_\_\_\_\_  
(DEPUTY)