

SURVEY FOR  
OREGON DEPARTMENT OF TRANSPORTATION  
**UNITY FOREST WAYSIDE -  
IRONSIDE SEC.**  
JOHN DAY HIGHWAY  
BAKER & MALHEUR COUNTIES

SHEET No.	13
TOTAL SHEETS	16

T. 14 S., R. 39 E., W.M.  
Portion of 9B-36-23

**MONUMENT TABLE (LEFT SIDE)**

PT. NO.	NORTHING	EASTING	STATION	OFFSET	BEARING	DISTANCE
388	250,157.12	8,861,764.52	869+00.00	45.00' LT.	S 2°54'08" E	5.00'
389	250,152.12	8,861,764.77	869+00.00	40.00' LT.	N 87°05'56" E	1100.00'
392	250,207.80	8,862,863.36	880+00.00	40.00' LT.	N 87°05'56" E	520.00'
395	250,234.11	8,863,382.69	885+20.00	40.00' LT.	N 2°54'05" W	5.00'
394	250,239.11	8,863,382.44	885+20.00	45.00' LT.	N 87°05'56" E	480.00'
398	250,263.40	8,863,861.82	890+00.00	45.00' LT.	N 87°05'56" E	1000.00'
400	250,314.01	8,864,860.54	900+00.00	45.00' LT.	N 87°05'56" E	1000.00'
402	250,364.63	8,865,859.26	910+00.00	45.00' LT.	N 87°05'56" E	1000.00'

*Flying O Cattle Company*  
128-51


*In Excess of 1,000 Acres Lt.*

*Fd. 3" Brass Disk Stamped  
"OREGON STATE HIGHWAY DIVISION  
BENCH MARK IRONS"  
(01-29-91)  
N. 250,338.87  
E. 8,865,535.27*

N. 87° 05' 56" E.

**MONUMENT TABLE (RIGHT SIDE)**

PT. NO.	NORTHING	EASTING	STATION	OFFSET	BEARING	DISTANCE
393	250,127.90	8,862,867.41	880+00.00	40.00' RT.	N 87°05'56" E	520.00'
396	250,154.22	8,863,386.74	885+20.00	40.00' RT.	S 2°54'01" E	5.00'
397	250,149.22	8,863,387.00	885+20.00	45.00' RT.	N 87°05'56" E	480.00'
399	250,173.52	8,863,866.38	890+00.00	45.00' RT.	N 87°05'56" E	1000.00'
401	250,224.13	8,864,865.10	900+00.00	45.00' RT.	N 87°05'56" E	1000.00'
403	250,274.74	8,865,863.82	910+00.00	45.00' RT.	N 87°05'56" E	1000.00'

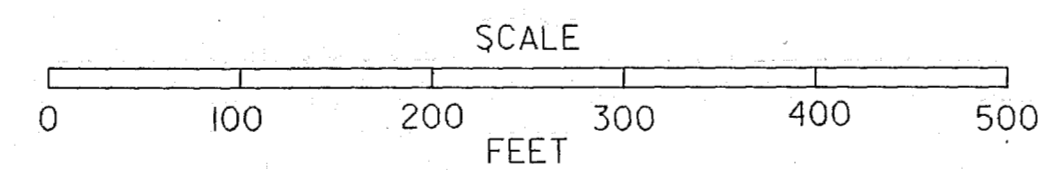

LOT 4

LOT 5

SEC. 30  
SEC. 29

FILED 5-24-94  
BAKER COUNTY SURVEYOR  
SURVEY NO. 14-38-12