

SURVEY FOR
OREGON DEPARTMENT OF TRANSPORTATION
**UNITY FOREST WAYSIDE -
IRONSIDE SEC.**
JOHN DAY HIGHWAY
BAKER & MALHEUR COUNTIES

SHEET No.	3
TOTAL SHEETS	16

MONUMENT TABLE (LEFT SIDE)

PT. NO.	NORTHING	EASTING	STATION	OFFSET	BEARING	DISTANCE
115	256,609.34	8,834,728.99	540+99.34	48.04' LT.		
117	256,206.57	8,835,067.70	546+09.30	44.83' LT.	S 40°03'43" E	526.26'
119	255,960.65	8,835,161.47	RW 548+11.81	40.00' LT.	S 20°52'18" E	263.18'
121	255,723.00	8,835,222.93	551+09.30	30.95' LT.	S 14°30'04" E	245.48'
123	255,704.88	8,835,227.62	551+28.02	30.74' LT.	S 14°30'04" E	18.72'
124	254,872.17	8,835,488.64	560+00.00	65.00' LT.	S 17°24'16" E	872.86'
126	254,642.63	8,835,597.44	562+50.00	110.00' LT.	S 25°21'29" E	254.02'
129	254,598.65	8,835,605.70	562+94.61	106.48' LT.	S 10°38'40" E	44.75'
131	254,296.33	8,835,662.52	565+75.00	120.00' LT.	S 10°38'40" E	307.62'
133	254,136.10	8,835,624.74	567+23.33	89.39' LT.	S 13°15'59" W	164.62'
138	254,060.92	8,835,607.02	568+00.00	80.00' LT.	S 13°15'45" W	77.24'
144	253,823.20	8,835,580.85	570+39.15	80.00' LT.	S 6°16'54" W	239.15'
151	253,414.01	8,835,564.66	574+64.14	66.87' LT.	S 2°15'57" W	409.51'
154	253,168.00	8,835,557.83	577+08.41	36.89' LT.	S 1°35'25" W	246.10'

G. W. Farley
E. Farley
M. Farley
82-105153

543+93.65 P.I.
"RW" 543+37.22 P.I.
N. 256,481.597
E. 8,834,985,415

T. 14 S., R. 38 E., W.M.
Portion of 9B-36-21


MALHEUR CO.
BAKER CO.

MONUMENT TABLE (RIGHT SIDE)

PT. NO.	NORTHING	EASTING	STATION	OFFSET	BEARING	DISTANCE
116	256,545.32	8,834,681.02	540+99.34	31.96' RT.	S 40°02'14" E	490.95'
118	256,169.44	8,834,996.84	546+09.30	35.17' RT.	S 20°51'24" E	244.86'
120	255,940.62	8,835,084.02	RW 548+11.81	40.00' RT.	S 14°30'04" E	246.39'
122	255,702.08	8,835,145.71	551+09.30	49.06' RT.	S 14°30'04" E	940.76'
125	254,791.29	8,835,381.28	560+50.00	59.78' RT.	S 14°30'05" E	208.04'
127	254,589.88	8,835,433.37	562+58.06	62.15' RT.	S 75°29'56" W	20.00'
128	254,584.87	8,835,414.01	562+57.83	82.15' RT.	S 14°30'04" E	36.81'
130	254,549.23	8,835,423.22	562+94.61	82.57' RT.	S 9°07'38" E	256.77'
132	254,295.72	8,835,463.96	565+71.45	78.53' RT.	S 0°47'28" E	142.15'
135	254,153.58	8,835,465.92	567+23.33	70.39' RT.	S 2°38'37" W	21.85'
136	254,131.76	8,835,464.91	567+45.15	69.01' RT.	S 17°35'55" W	157.93'
142	253,981.22	8,835,417.16	569+00.00	100.00' RT.	S 1°31'05" W	60.21'
143	253,921.03	8,835,415.56	569+60.00	95.00' RT.	S 1°24'51" E	79.87'
146	253,841.18	8,835,417.54	570+39.15	84.30' RT.	S 1°24'29" E	440.20'
153	253,401.11	8,835,428.40	574+64.14	70.00' RT.		

Davis Land & Livestock Co.
124-569

SEE IR-2-1434
State of Oregon
State Highway Commission
60-594

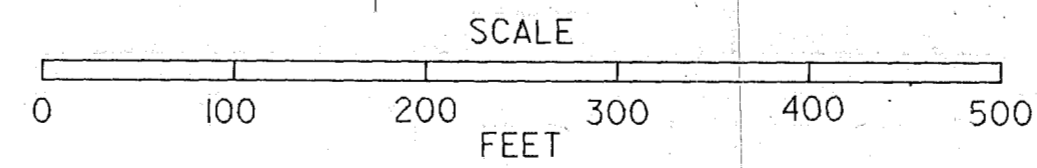

/usr/rw/projects/04838/04838rws2q_02-MAY-1994

VIEW=P3

FILED 5-24-94
BAKER COUNTY SURVEYOR
SURVEY NO. 14-38-12