

12
1/4 cor. 13

Found old Juniper post used as corners


SURVEY of LOT'S 3 & 4, BLOCK 49 HUNTINGTON TOWNSITE BAKER COUNTY OREGON

Scale 1" = 50'

Date 12-1-75

(1327.10 R/R)
1326.54

(1327.10 R/R)
1326.54

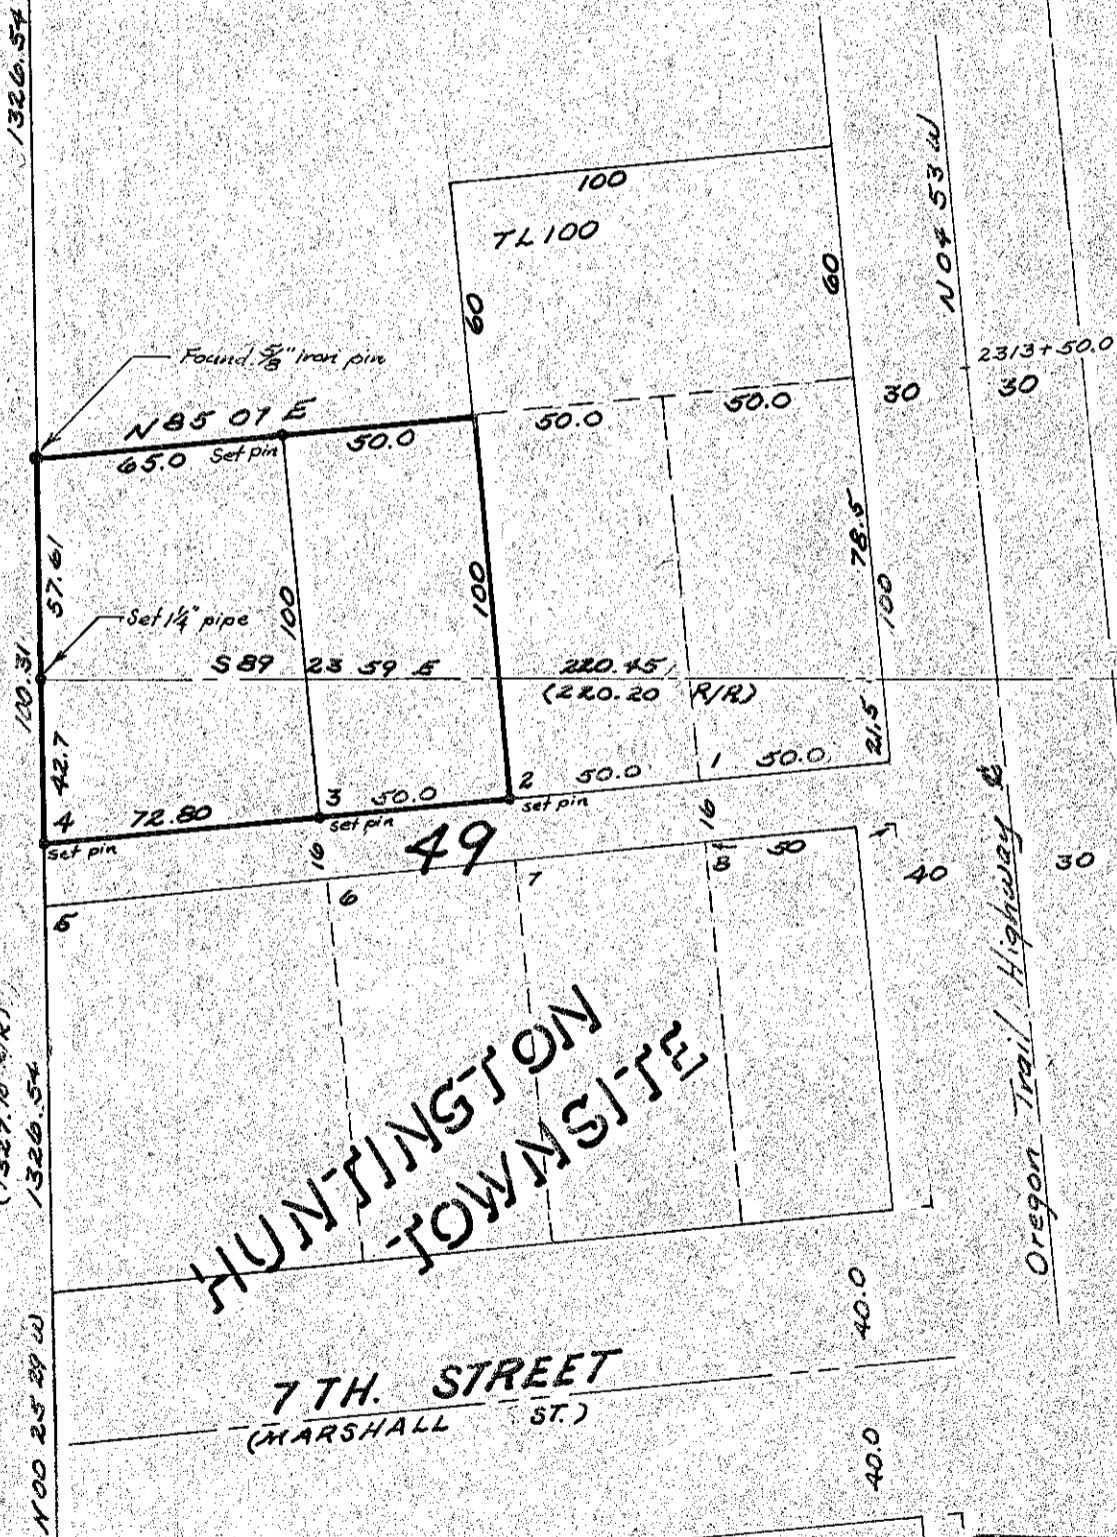

NOTE: Used Oregon Trail Highway center line as bases of bearing for this survey.

HUNTINGTON TOWNSITE

7TH STREET (MARSHALL ST.)

REGISTERED PROFESSIONAL LAND SURVEYOR

James H. Hambleton

FILED Dec. 3, 1975

BAKER COUNTY SURVEYOR
SURVEY NO. 14-44-4

OREGON
JULY 13, 1961
JAMES H. HAMBLETON
645

C/4
Sec. 13