


Jefferson St. bears S 04° 28' E  
as noted on Philo Anderson  
map of 1954

4

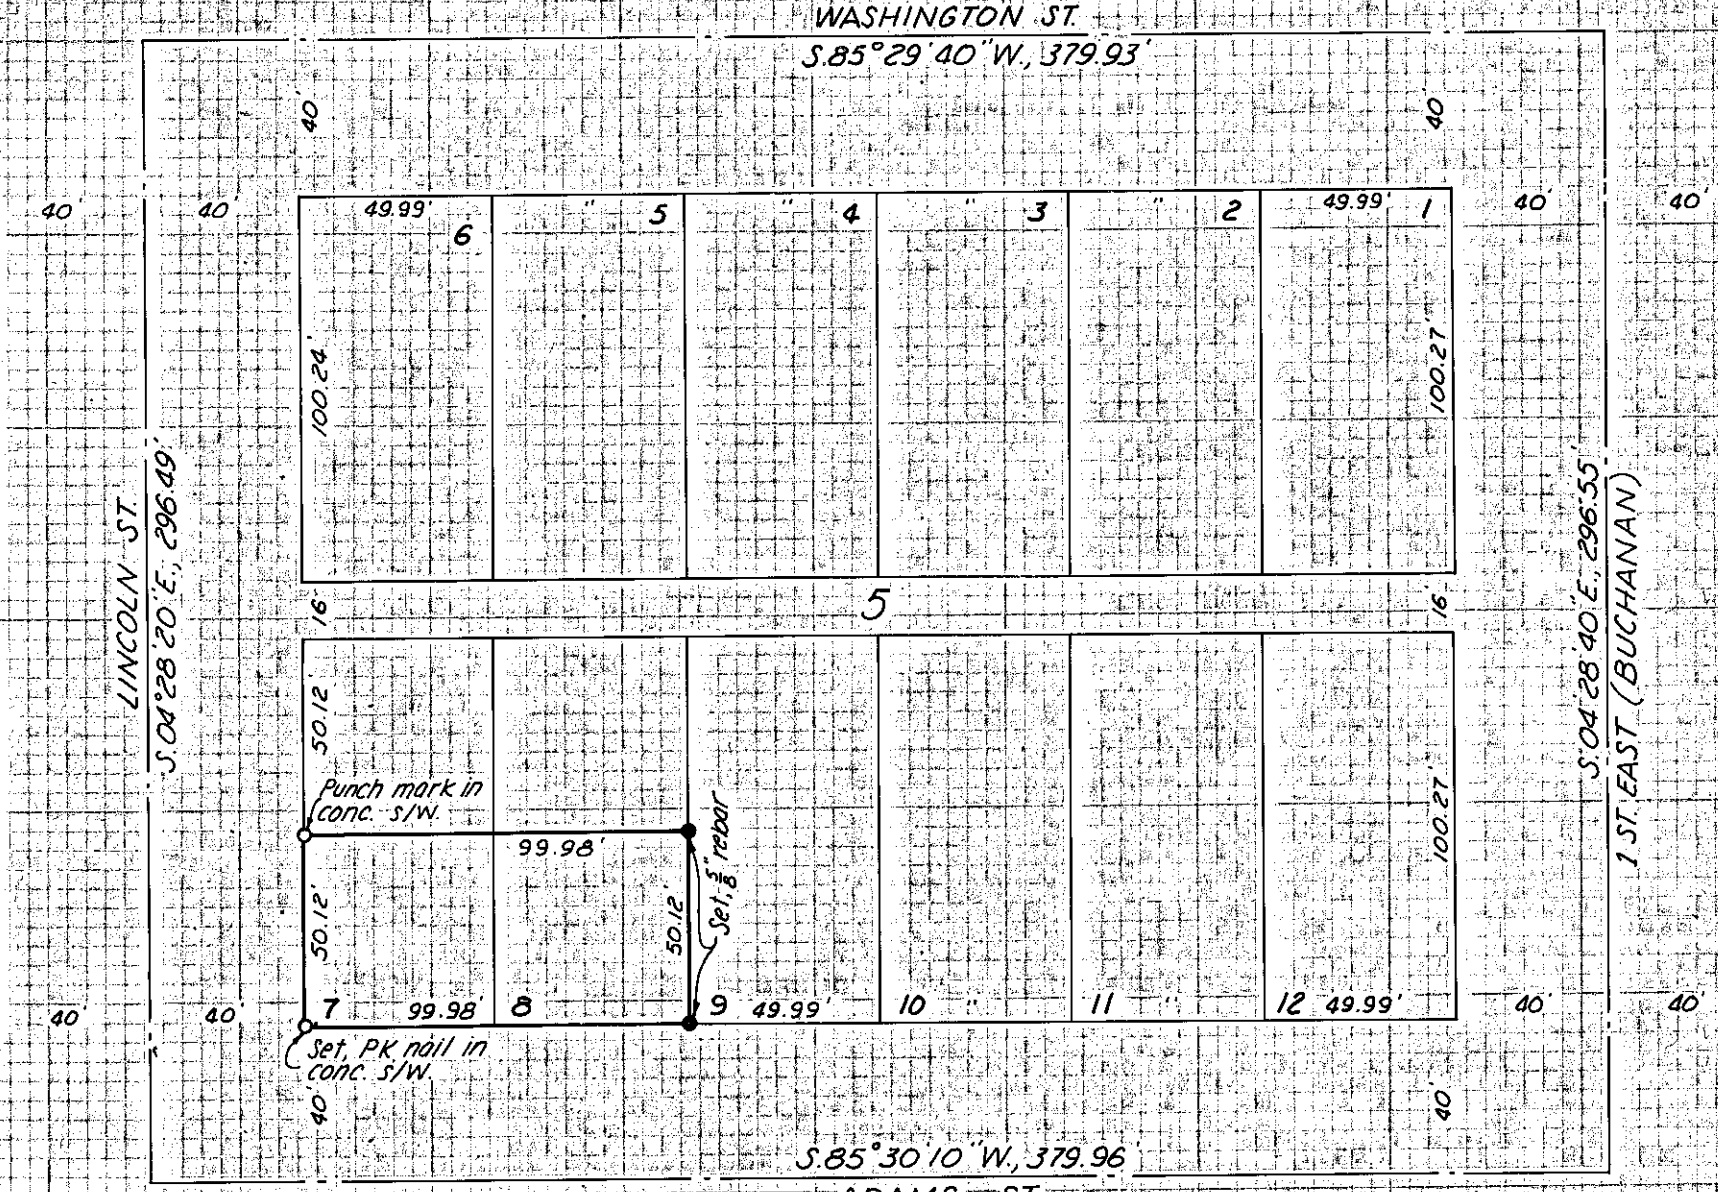

NOTE  
Found  
1st  
1st  
6st  
6st  
No other  
vicinity  
Method  
measured  
to ascend

6

FILED Aug. 8, 1977  
BAKER COUNTY SURVEYOR  
SURVEY NO. 14-44-6

MAP OF SURVEY  
THE S 1/2 LOTS 7 & 8, BLOCK 5, HUNTINGTON TOWNSITE  
HUNTINGTON, OREGON

Surveyed Aug. 1 & 5, 1977 Scale 1" = 50'  
For Mrs. Geraldine Smith

