


Exhibit "A"

City of Huntington
Reservoir Site Survey
NE 1/4, NE 1/4, SW 1/4, Sec 13
T14S, R44E, WM
Baker County, Oregon

Contract Purchaser:
Dennis D. & Janelle Quast
Rt. 1, Huntington, Oregon



Scale 1"=100'

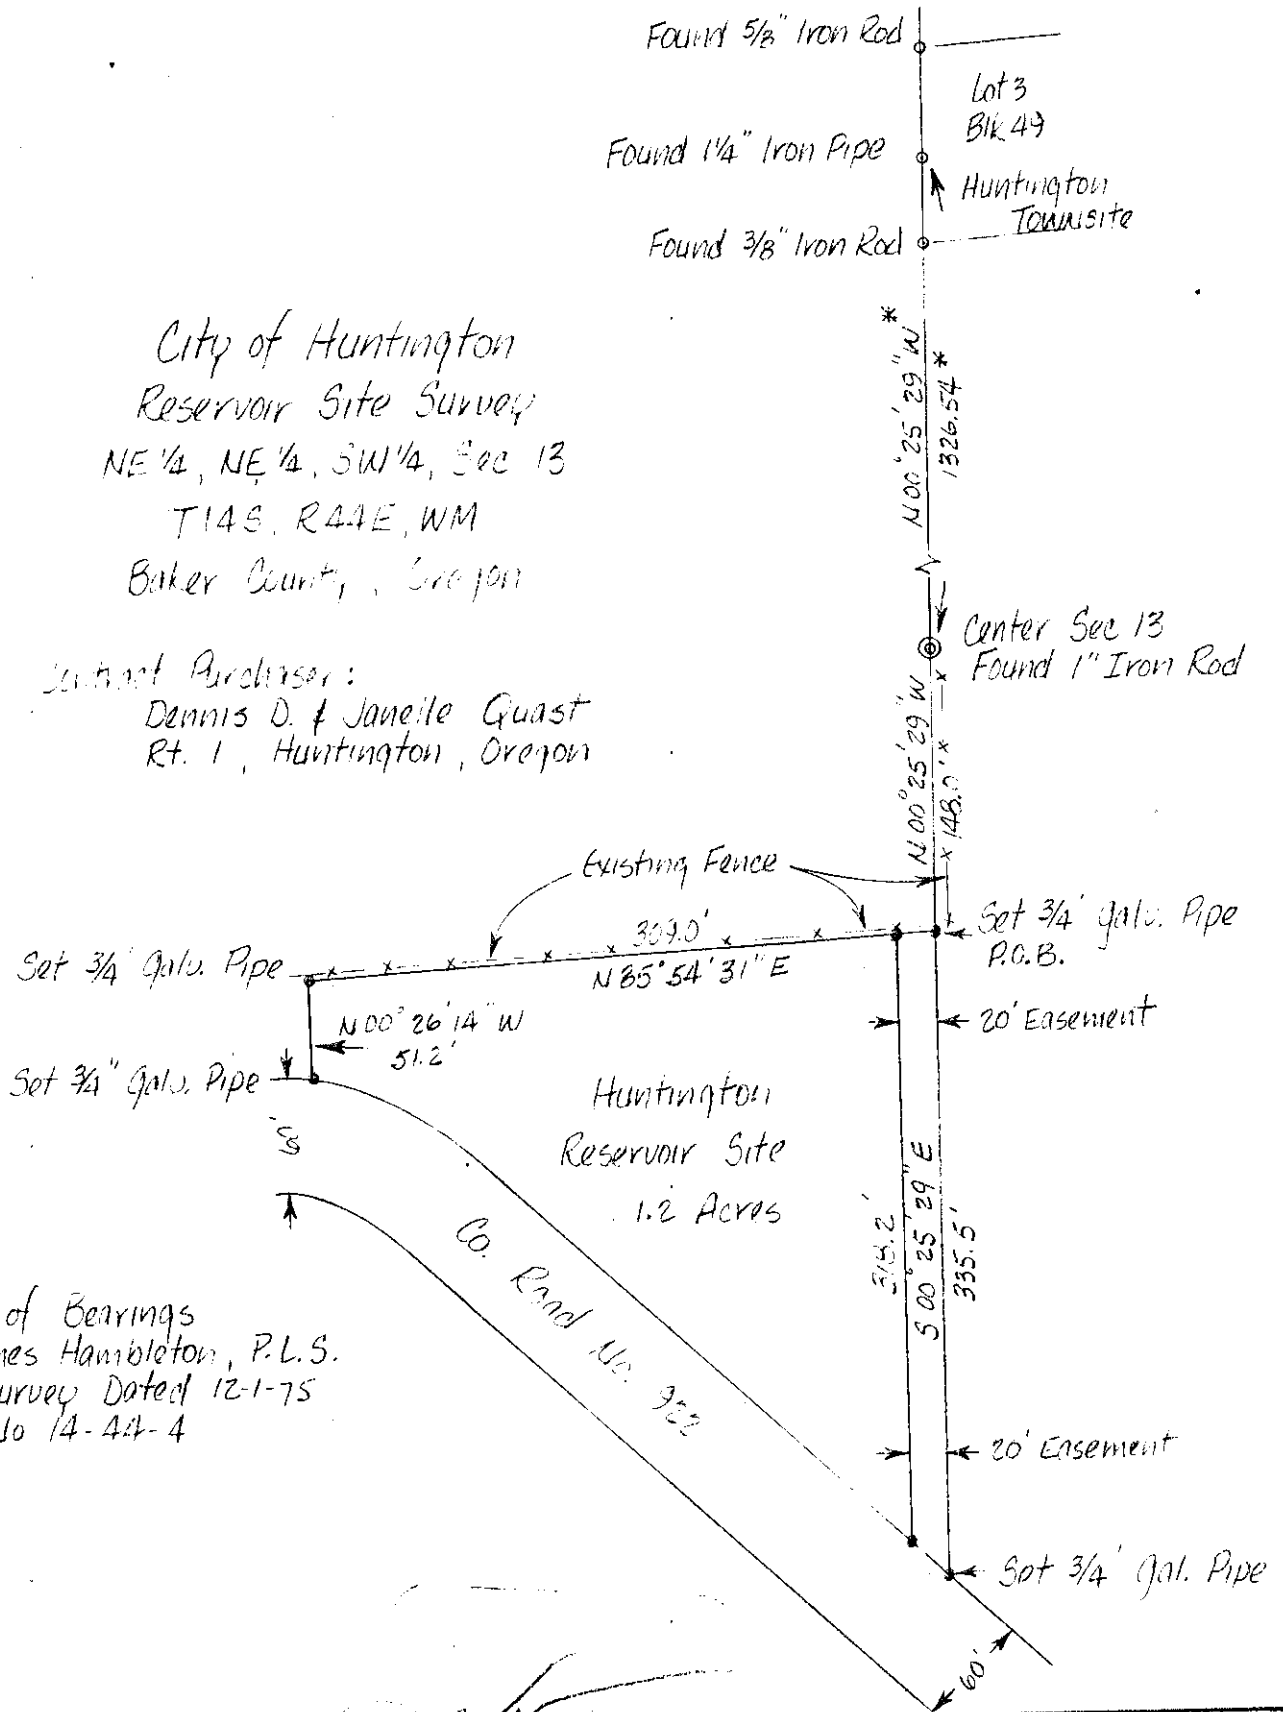

* Basis of Bearings
James Hamblton, P.L.S.
Survey Dated 12-1-75
No 14-44-4

J. Val Toronto

J. VAL TORONTO & ASSOC., INC.
CONSULTING ENGINEERS
PENDLETON, OREGON

FILED... Ap. 24, 1979
BAKER COUNTY CLERK
SURVEY NO. 14-44-9

JWD 3/12/19