



RECORD OF SURVEY

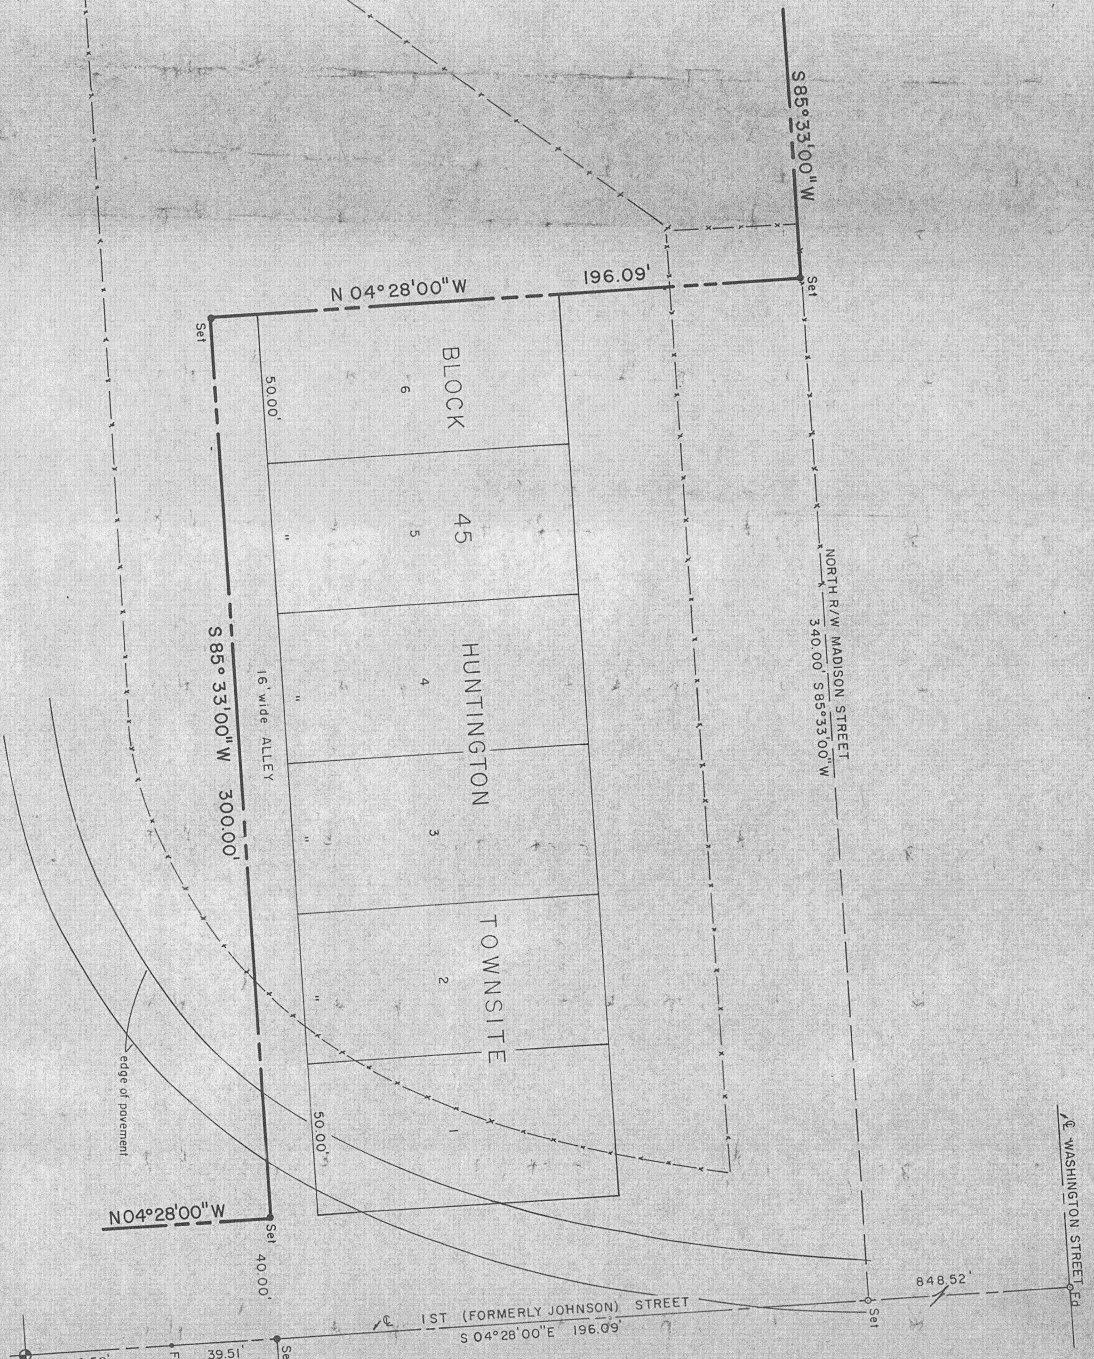

WASHINGTON STREET EA

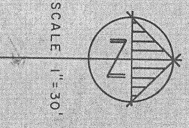

- LEGEND**
- PROPERTY LINE
 - - - CENTERLINE
 - ROAD RIGHT OF WAY
 - BRASS CAP
 - 1/2" Ø REBAR
 - P K NAIL

Note
 Basis of Bearings
 1st Street West (Johnson)
 bears $S 04^{\circ} 28' E$ as noted
 on Philo Anderson map of
 1954.


FILED Feb 18, 1979
 BAKER COUNTY SURVEYOR
 SURVEY NO. 1A-44-10

SURVEY FOR -

DARLENE GRAVES

BLAKLEY ENGINEERS, INC.
 CHARTERED

CALDWELL PAVETTE EMMETT ONTARIO

DATE 9-26-79 DRAWN & VM CHECKED

JOB NO. S0082379 BOOK 5 50 PAGES

REV 12-21-79 BY D.A.D. CHANGE BEARING APPROV