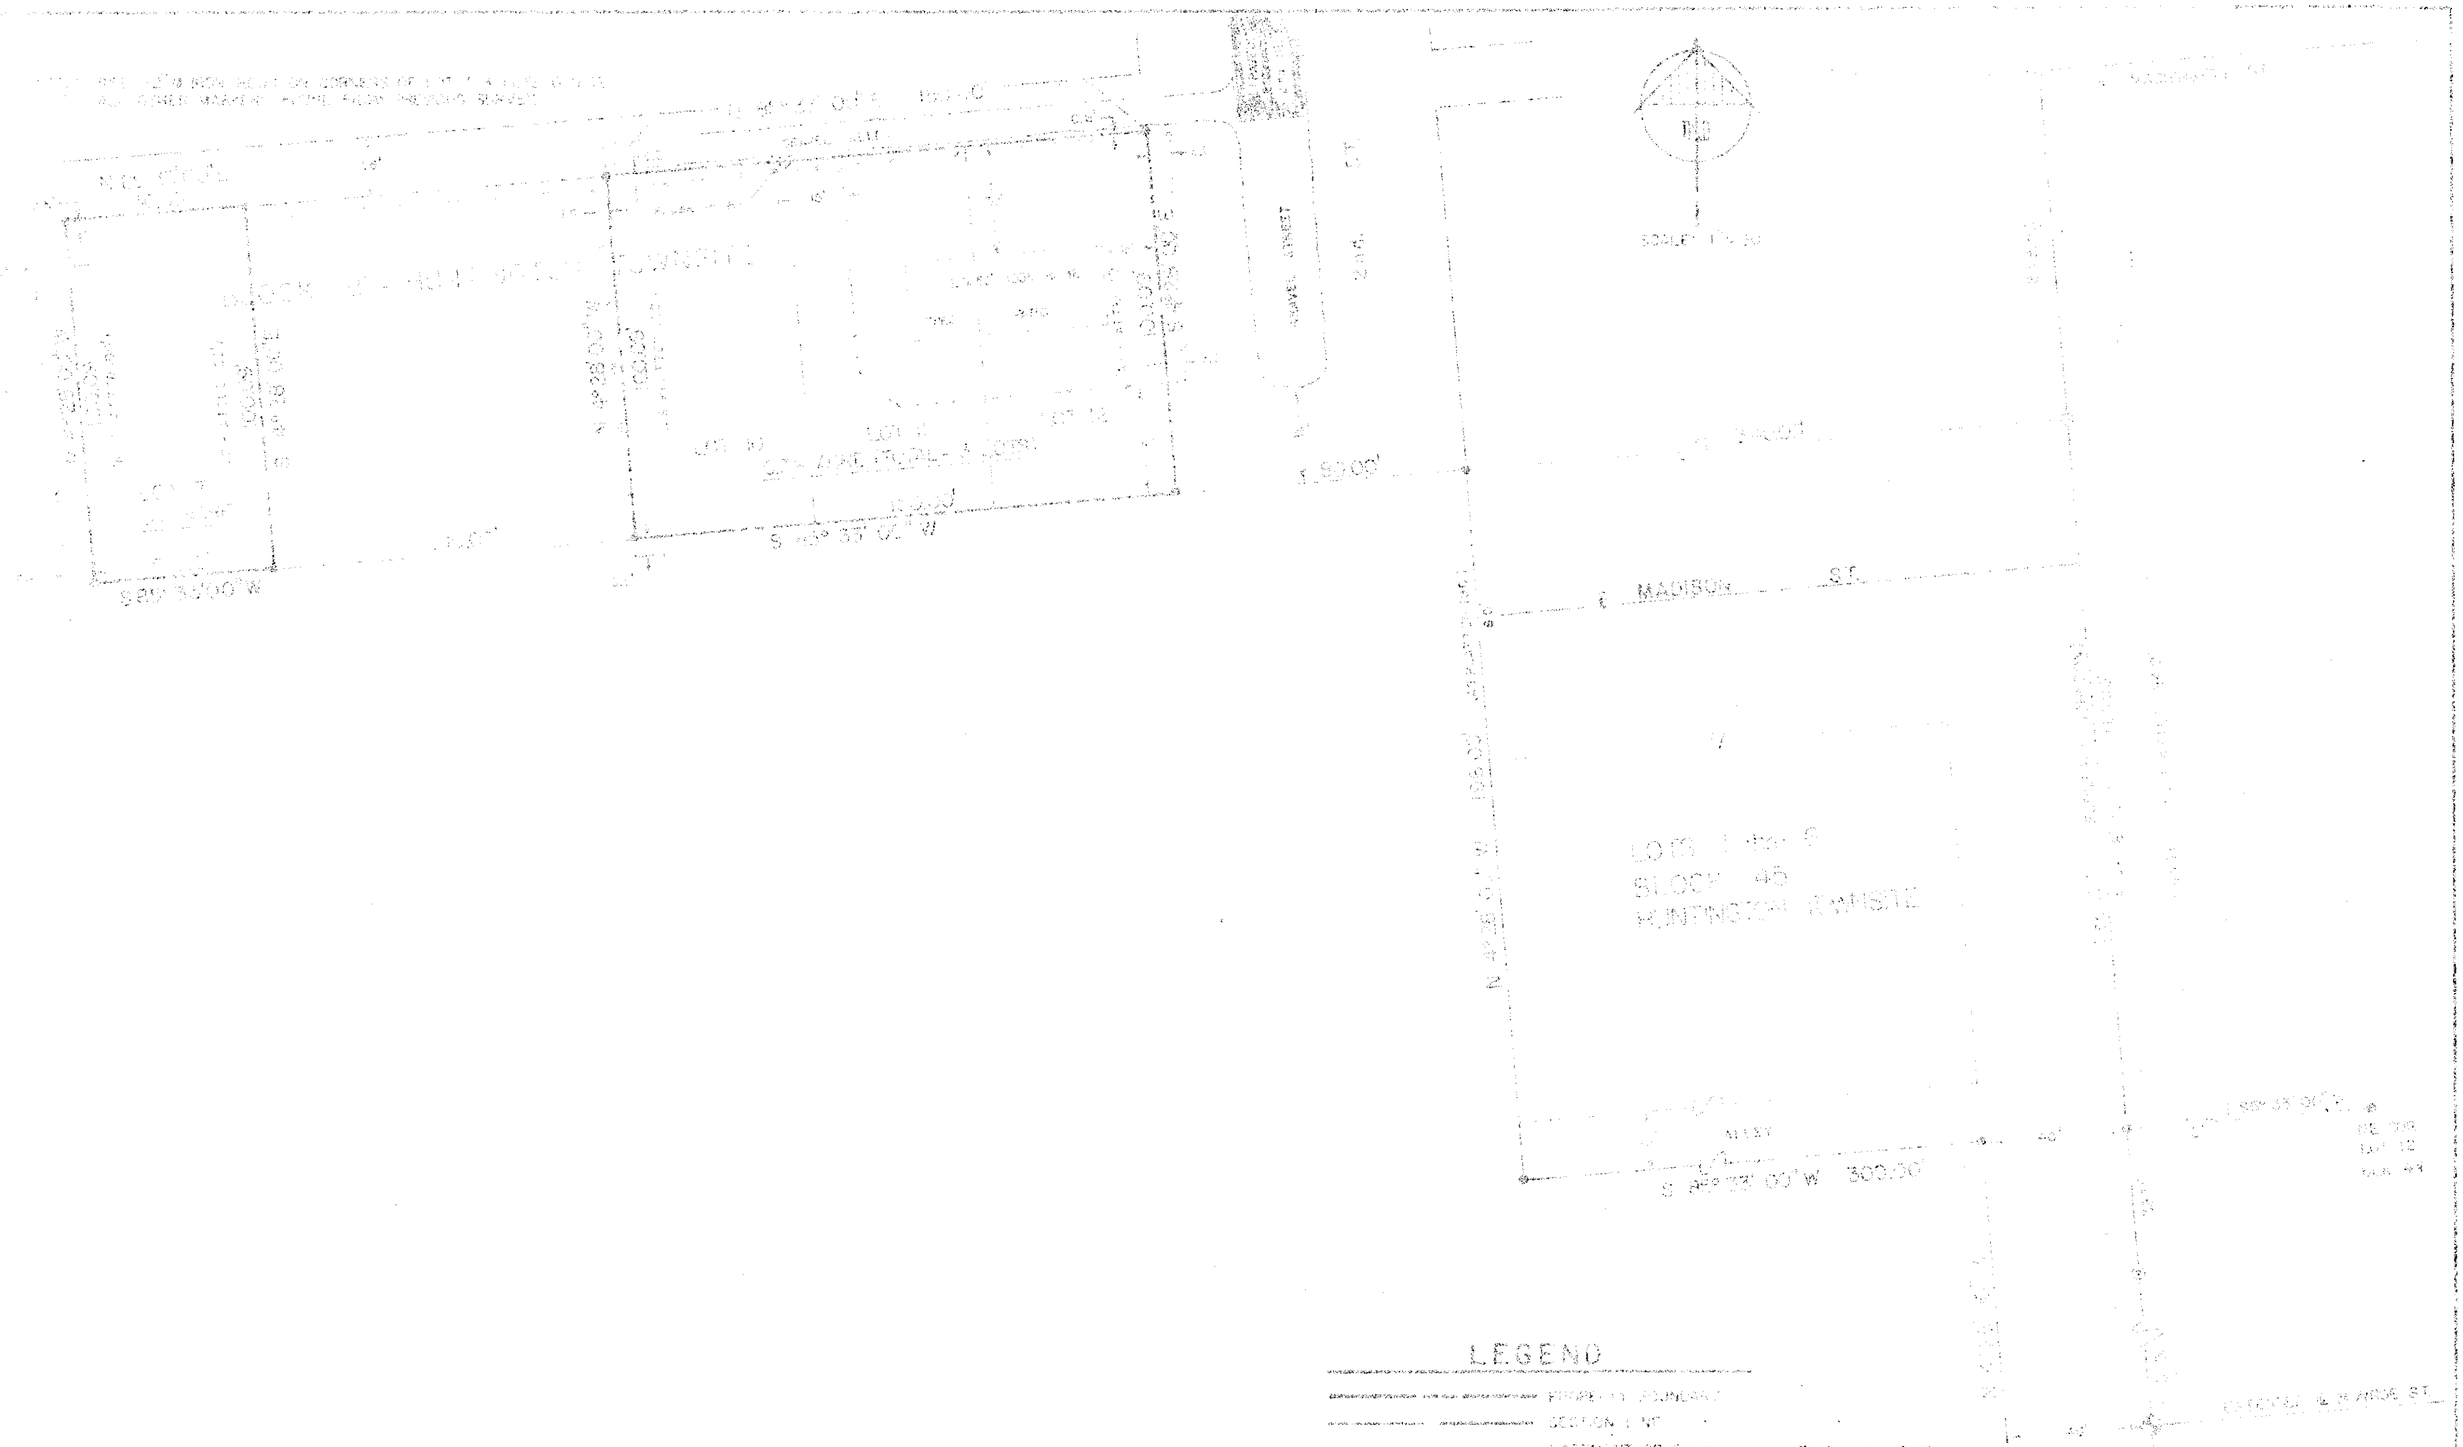
MADISON ST.
ALLEY
S 88° 33' 00" W 300.00'
LEGEND
PROPERTY BOUNDARY
SECTION LINE
EASEMENT OR R.O.W.
CENTERLINE
FENCE
DITCH OR CANAL
BRASS CAP
5/8" Ø IRON ROD
1/2" Ø IRON ROD
R.R. NAIL
POB POINT OF BEGINNING
TPB TRUE POINT OF BEGINNING
FILED Feb. 18, 1979
BAKER COUNTY SURVEYOR
SURVEY NO. 14-44-11
RECORD OF SURVEY
DARLENE GRAVES
BLAKLEY ENGINEERING INC

14-44-11